

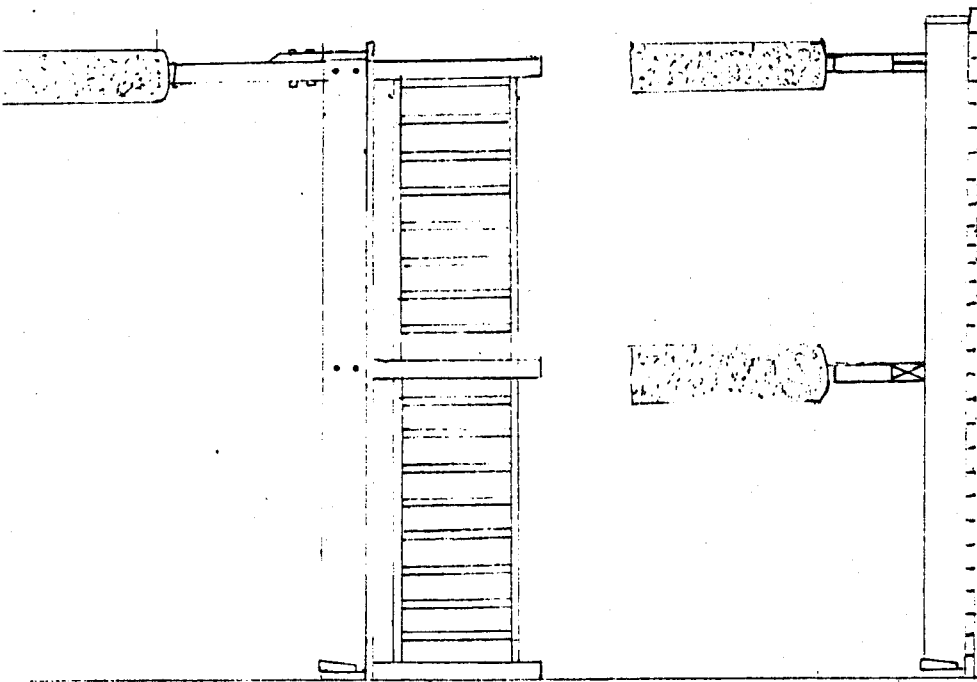
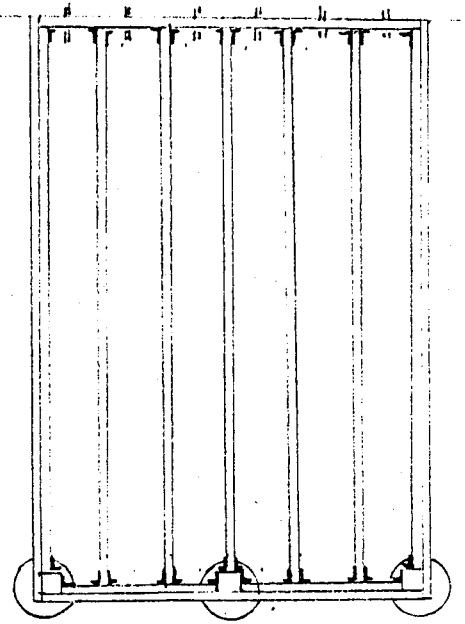



SAMPLE

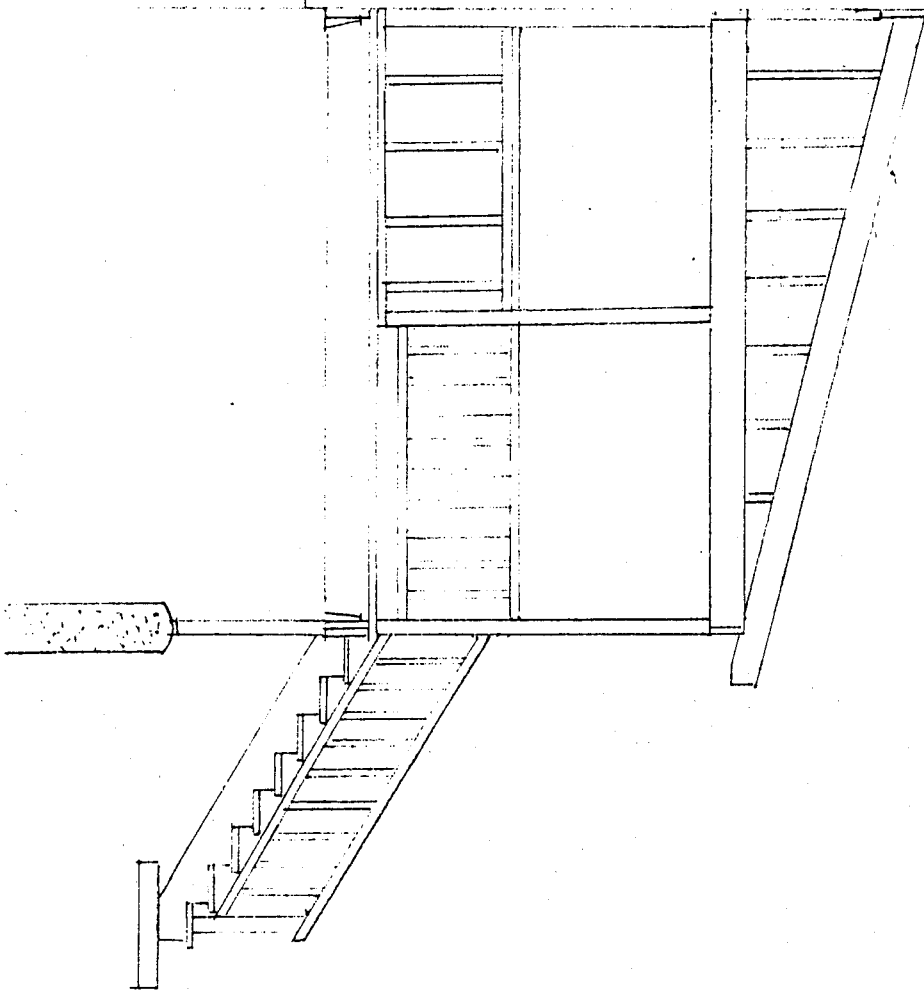

SAMPLE

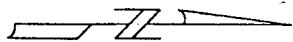

NOCKET ROAD

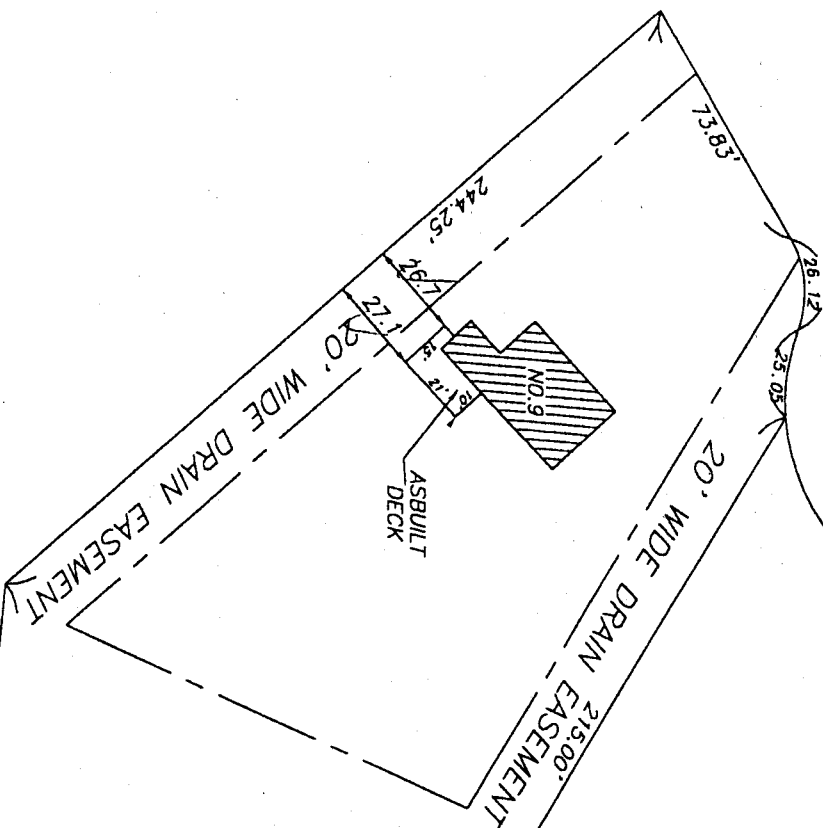

ASBUILT DECK
AT 9 NOCKET ROAD
FRANKLIN, MASS.

SCALE 1"=40' OCTOBER 24, 2000

P.L.S. FRANKLIN, MASS.



INSPECTION D

TOWN OF FRA
RECEIVED

DRAIN EASEMENT
LOT 9
73,913 55P S.F.