
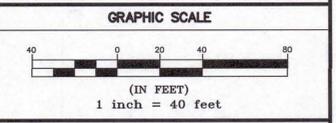
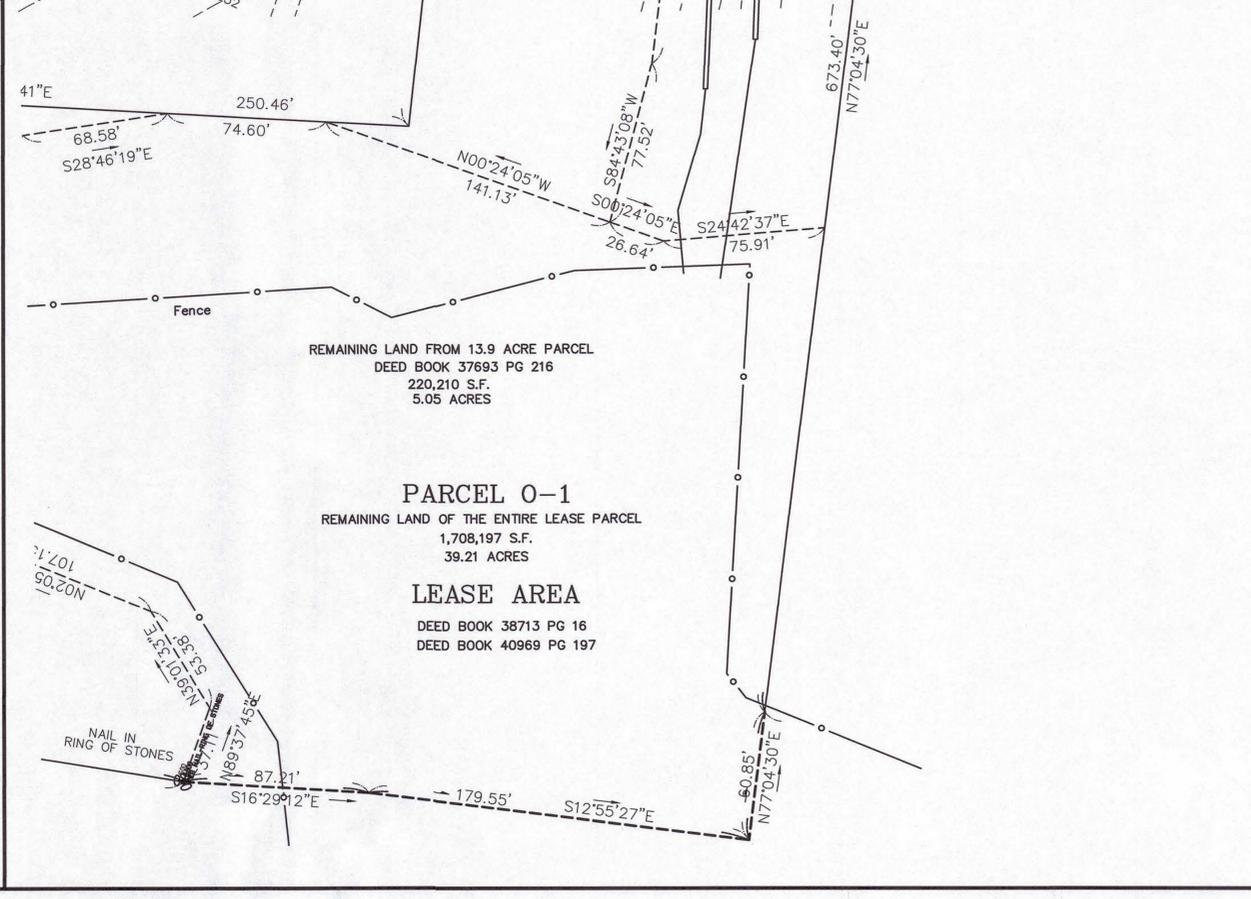
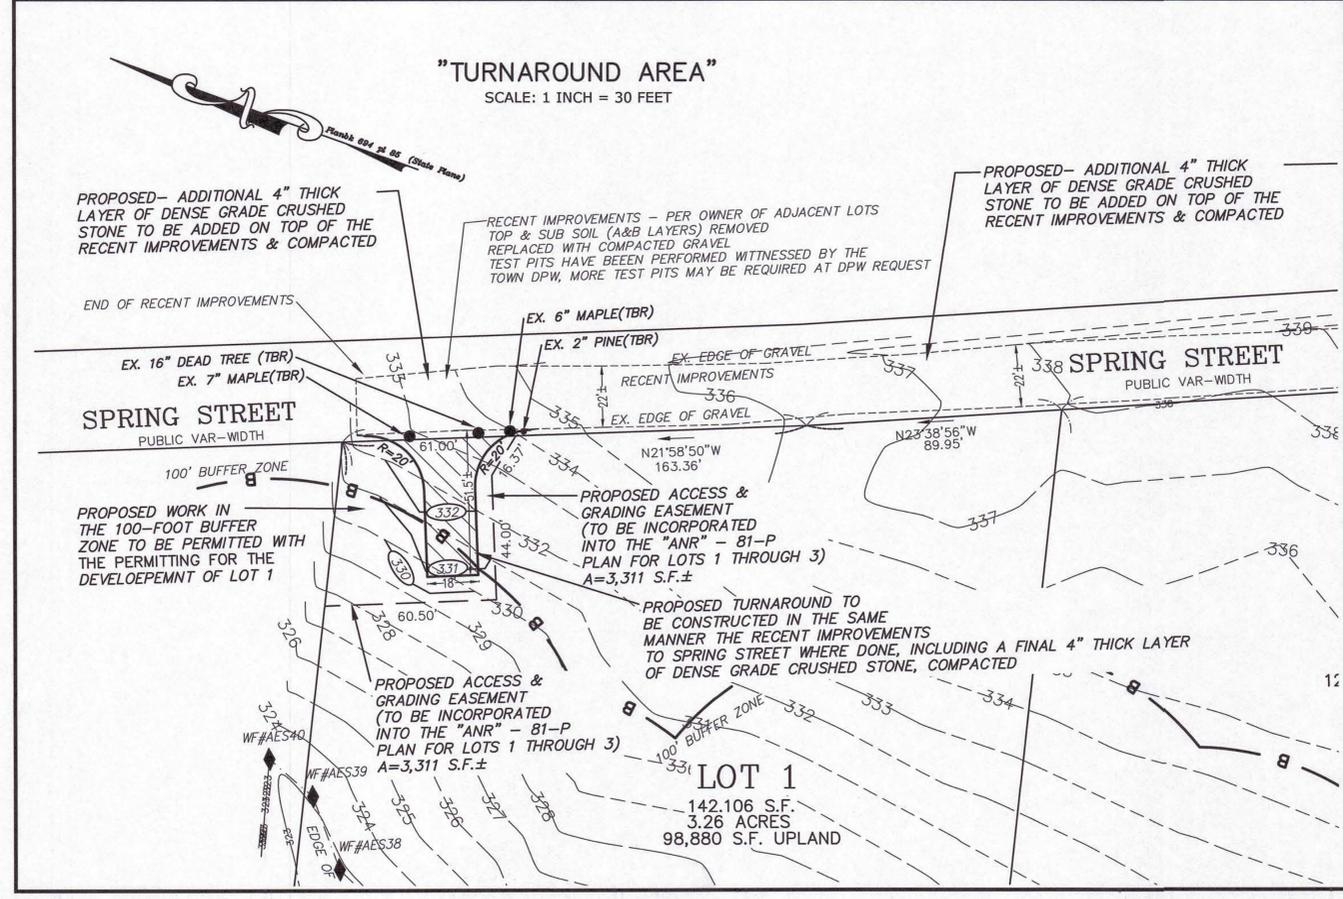


P.E. P.L.S.
MICHAEL DEAN
No. 4625
9-16-24

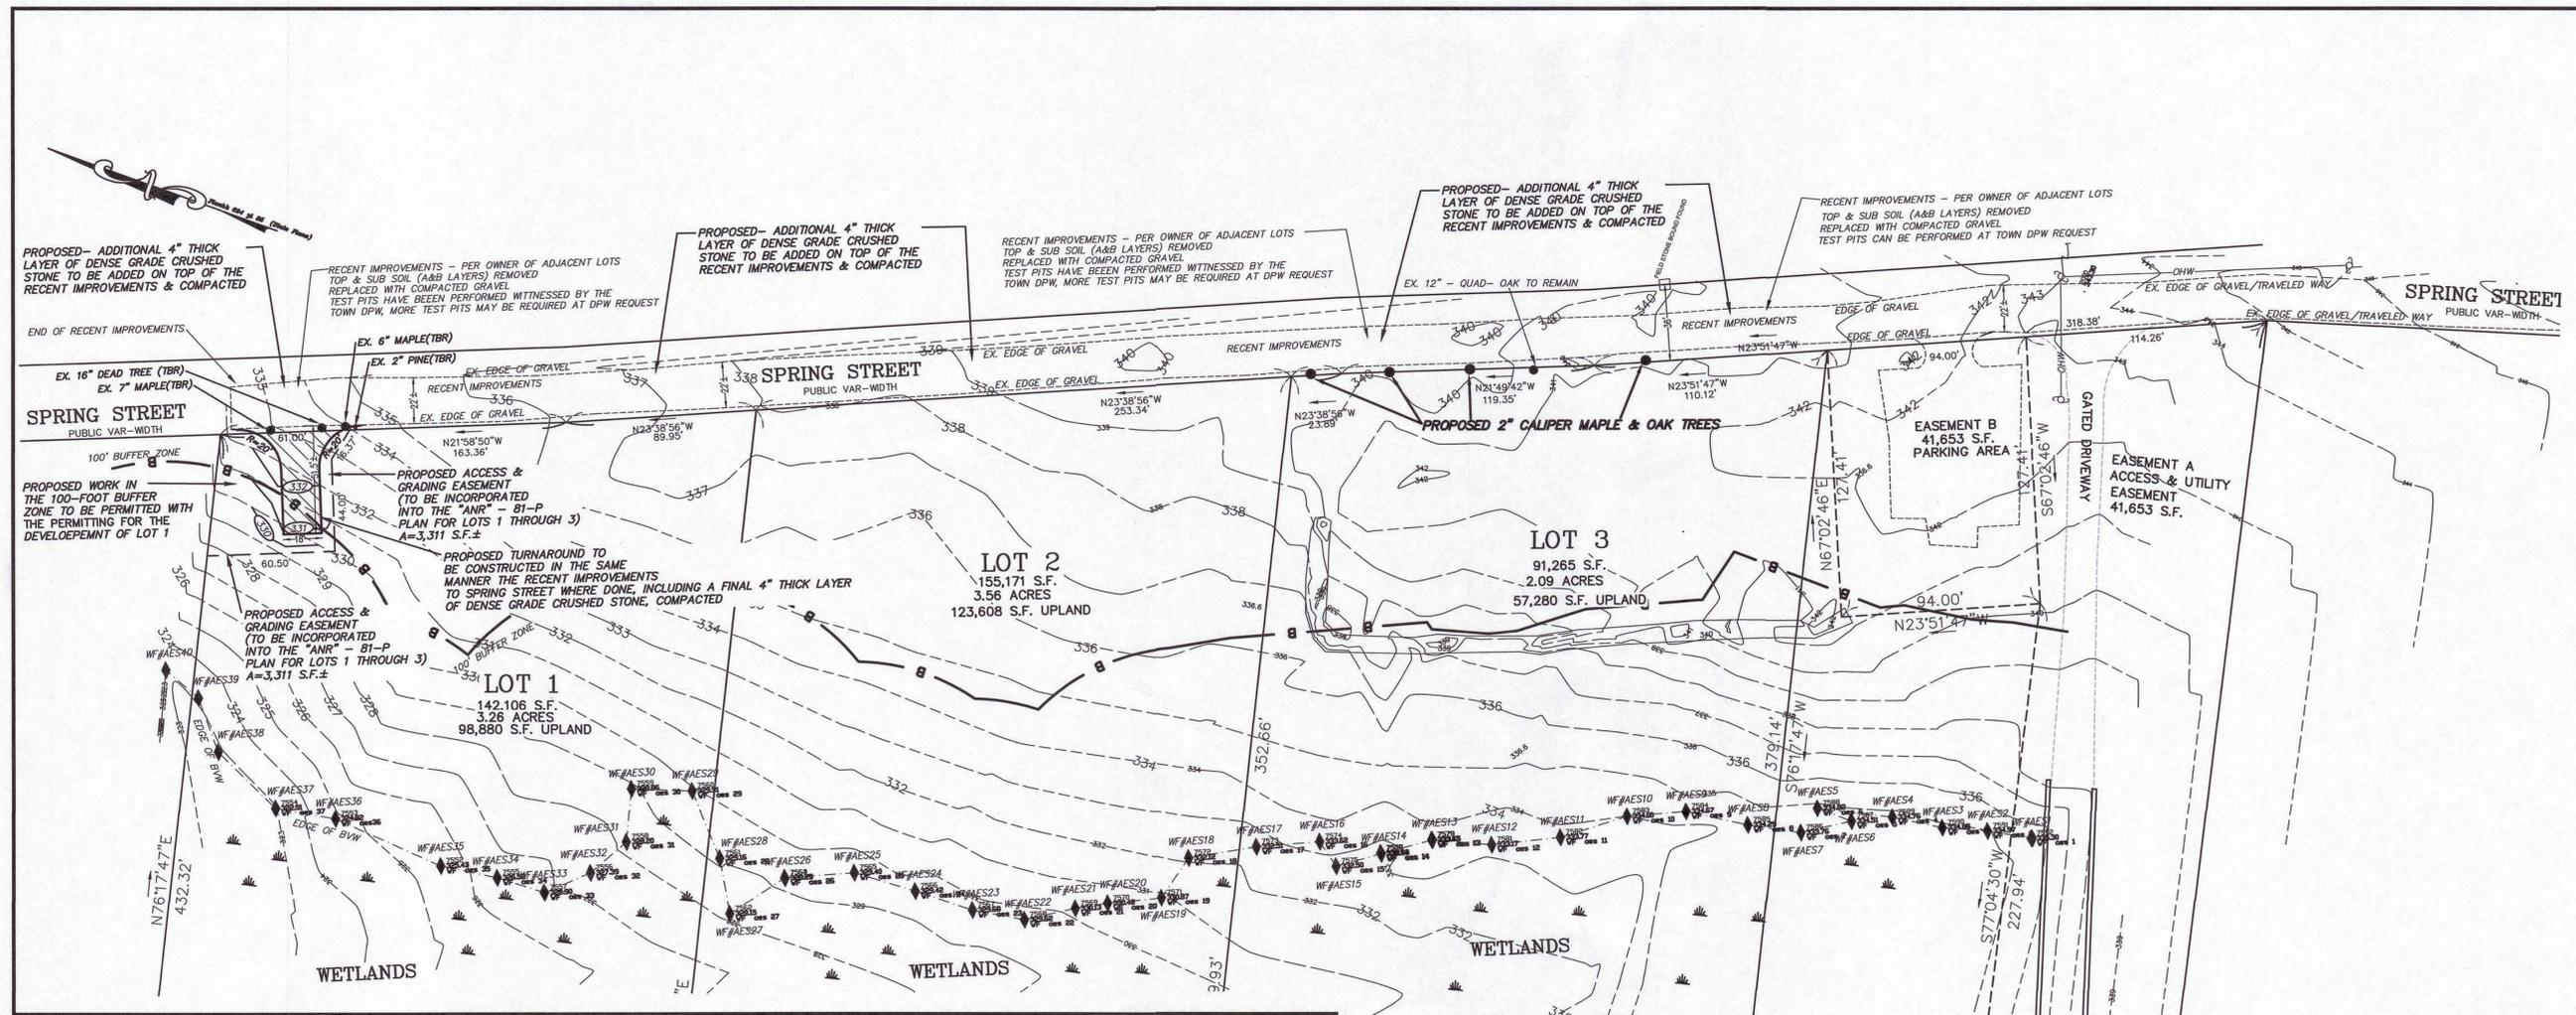

REVISIONS

REV.	DATE	DESCRIPTION
#1	7/31/24	TURNAROUND & DENSE GRADE
#2	9/16/24	EXIST TREES & PROPOSED TREES

PROJECT NO.	J-177
DESIGNED BY	PML
CHECKED BY	MD
DATE	5/23/24
CAD FILE	J-177 EC.dwg
PLAN NO.	

PREPARED FOR:
LEWIS STREET REALTY, LLC
28 Tia Place, P.O. Box 411
Franklin, Ma 02038

TITLE:
**Spring Street
"Improvements"
As-built Conditions
&
Proposed Turnaround Plan
Franklin, Massachusetts**

SHEET TITLE
**EXISTING CONDITIONS &
TURNAROUND**
SHEET 1 OF 1

SHEET NO.
C-1.0