


Lot 469

78,730± S.F.




Legend	
	Catch Basin
	Drain Manhole
	Sewer Manhole
	Contour Proposed
	Spot Grade Proposed
	Contour Existing
	Spot Grade Existing
	Utility Pole
	Water Gate Valve
	Hydrant
	Bound Found
	Drill Hole Found
	Iron Pin Found
	Proposed Bound
	Gray Dogwood (Cornus racemosa)

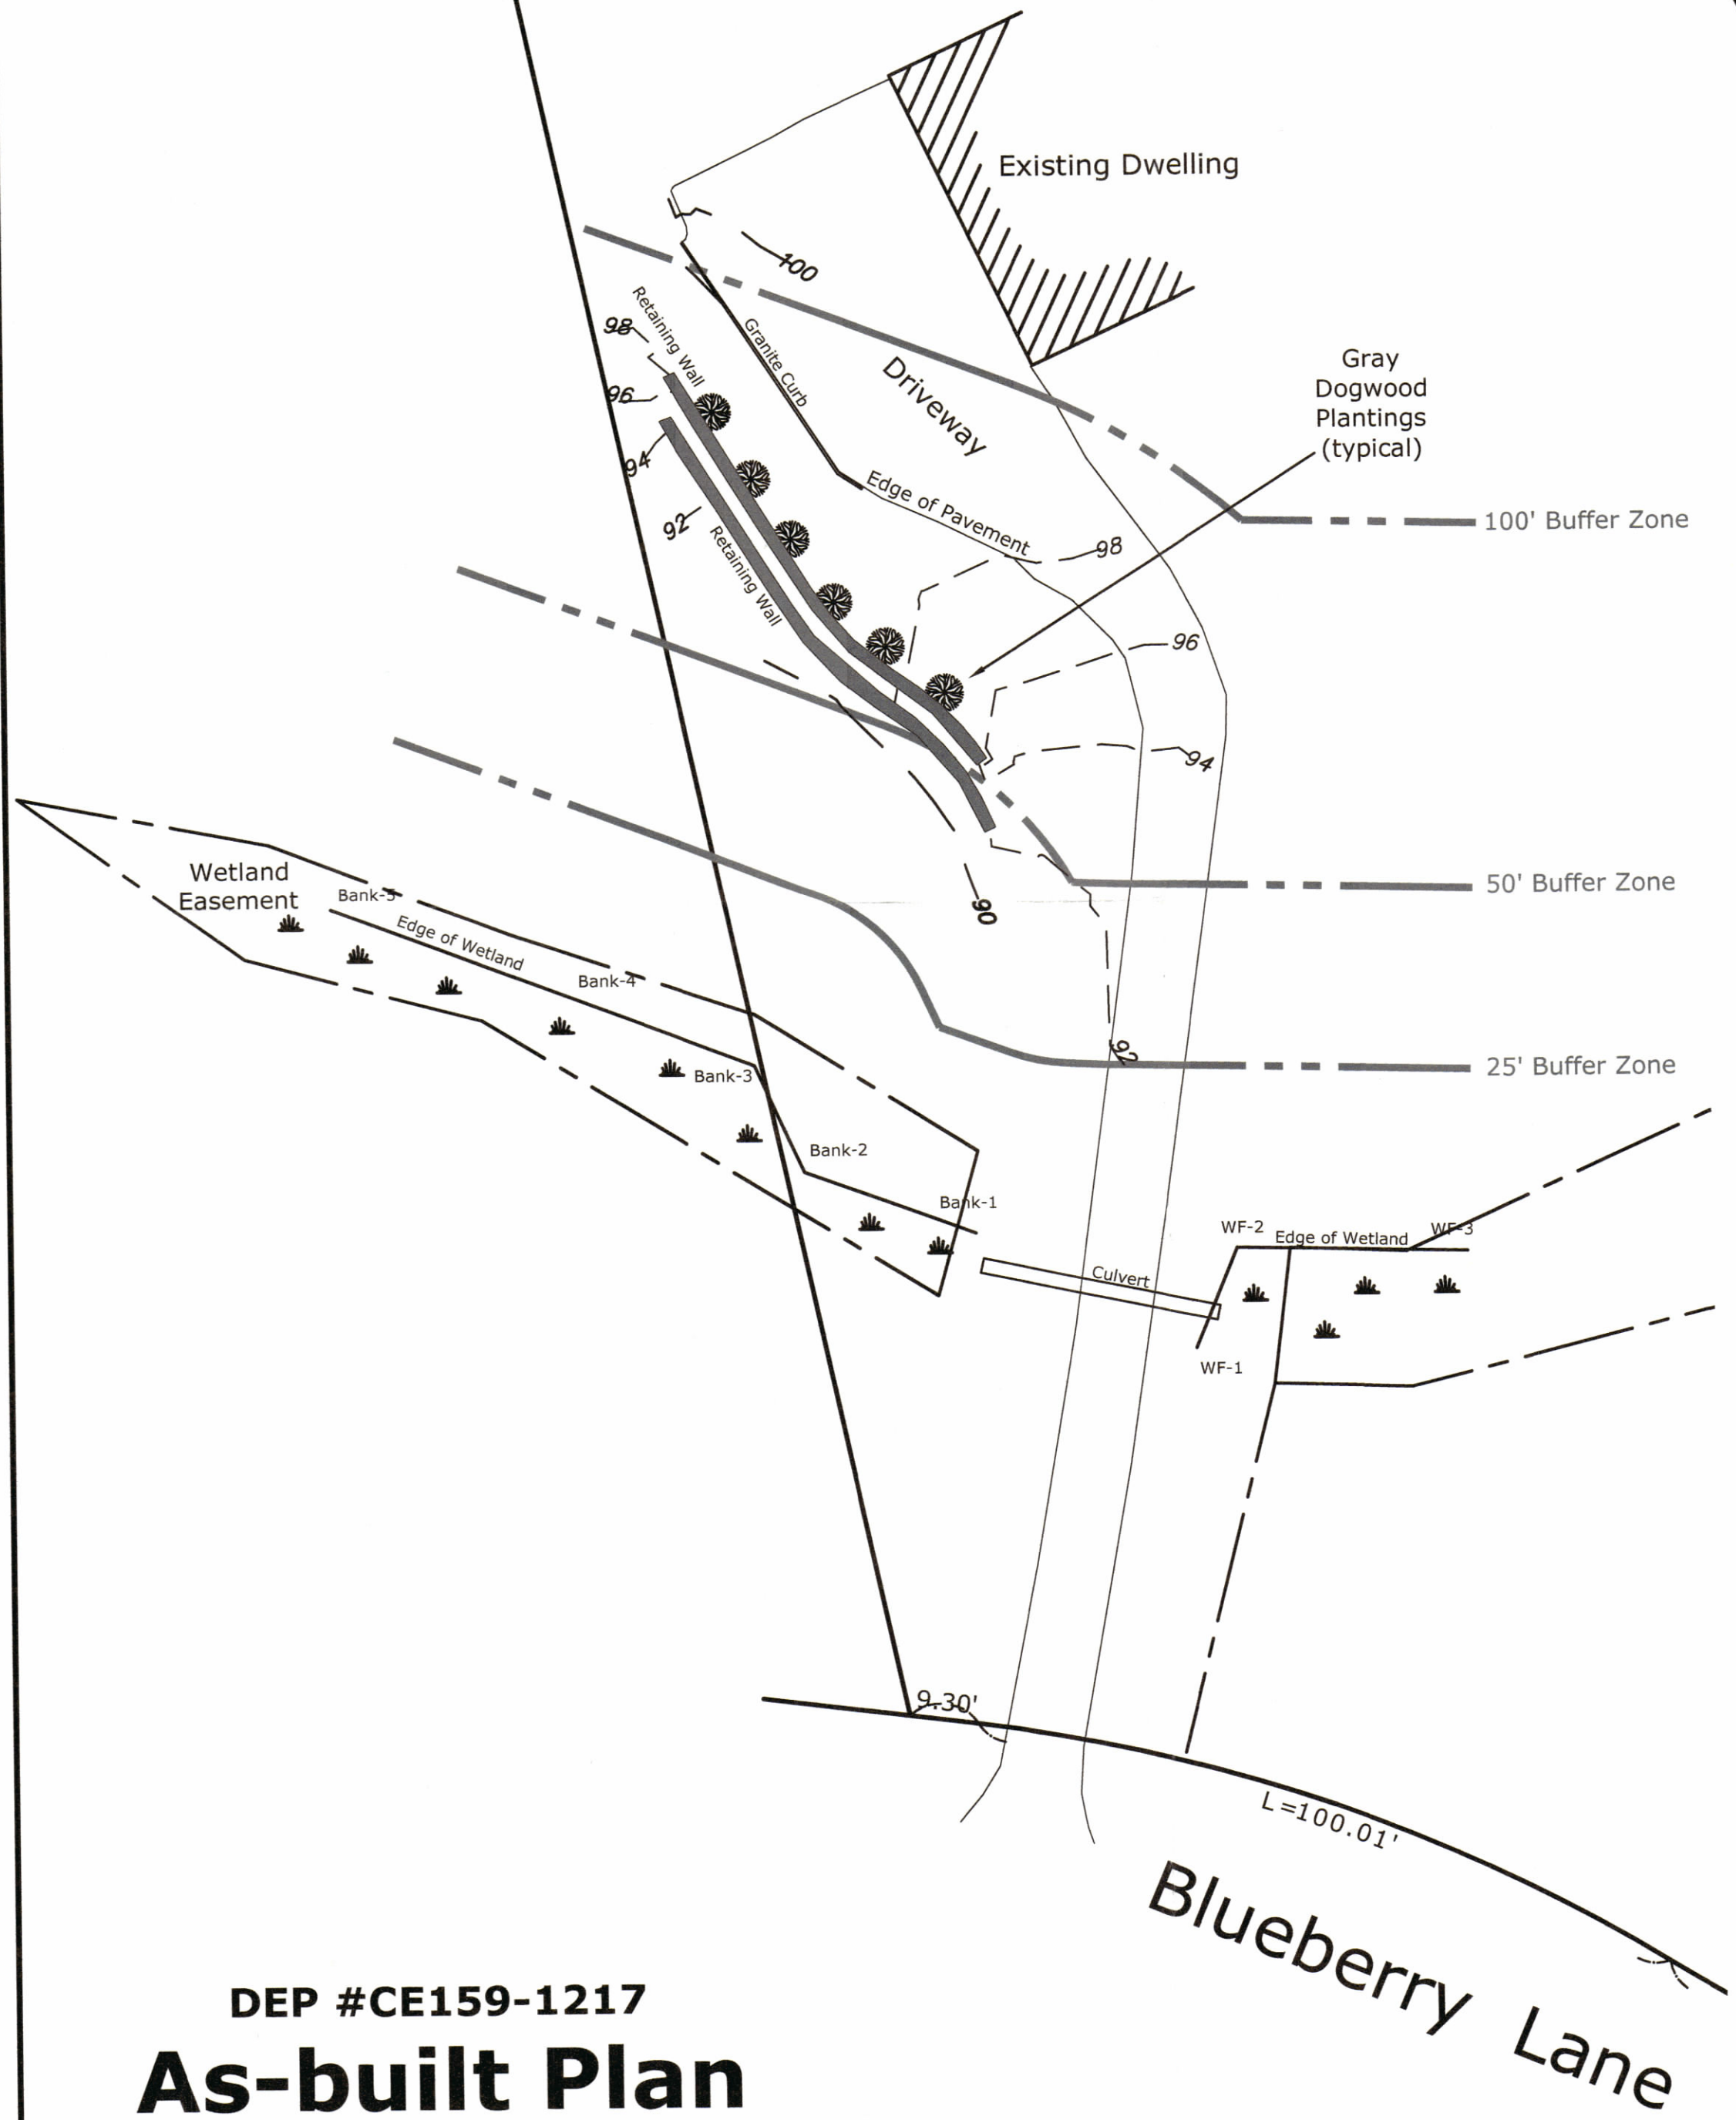

REVISIONS			
No.	Date	Design	Checked
1			
2			
3			
4			
5			
6			

Field By:	BH/DL	9/21
Designed By:		
Drawn By:	WDH	3/23
Checked By:	NGH	NGH

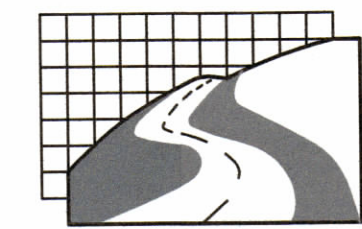

Land Planning, Inc.
Civil Engineers • Land Surveyors
Environmental Consultants

Bellingham
167 Hartford Ave.
Bellingham, MA 02019
508-966-4130

North Grafton
214 Worcester St.
N. Grafton, MA 01536
508-839-9526

Hanson
1115 Main Street
Hanson, MA 02341
781-294-4144

bellingham@landplanninginc.com

DEP #CE159-1217
As-built Plan
Located at
39 Blueberry Lane
Franklin, MA
Owned by
Sean Williams



Date	March 6, 2023	Sheet No.	1
Job No.	B2577		