Tel: (508) 520-4907 Fax: (508) 520 4906

## Town of Franklin



## **Planning Board**

Due to the growing concerns regarding the COVID-19 virus, we will be conducting a remote/virtual Planning Board Meeting. In an effort to ensure citizen engagement and comply with open meeting law regulations, citizens will be able to dial into the meeting using the provided phone number (Cell phone or Landline Required) OR citizens can participate by copying the link (Phone, Computer, or Tablet required).

Please click on the link <a href="https://us02web.zoom.us/j/82517654322">https://us02web.zoom.us/j/82517654322</a> or call on your phone at 312-626-6799, meeting # 82517654322.

## **April 5, 2021**

7:00 PM	Commencement/General Business	
7:05 PM	PUBLIC HEARING – Continued Site Plan – 27 Forge Parkway Site Plan Modification TO BE CONTINUED	Adv. Feb. 8 & Feb. 15, 2021 Abutter Feb. 5, 2021
7:05 PM	PUBLIC HEARING- Continued Olam Estates – 900 Washington St Definitive Subdivision TO BE CONTINUED	<b>Adv.:</b> Jan. 25 & Feb. 1, 2021 Abuts: Jan. 22. 2021
7:10 PM	PUBLIC HEARING - Continued 515 West Central Street Site Plan	<b>Adv.:</b> Nov. 2 & Nov. 9, 2020 Abuts: Nov. 2, 2020

## **GENERAL BUSINESS:**

A: Final Form H: 45 Forge Parkway – YMCA

B: 81-P ANR: Prospect Street

C: Street Acceptance: Brandywine Drive & Charles Drive from Station 0+00 to Station 2+51.71

D: **Discussion**: Countryside Estates - sidewalk

#### This agenda is subject to change. Last updated: March 31, 2021


The next meeting of the Planning Board is scheduled for April 26, 2021.

THE BUILDING OFFSETS SHOWN HEREON ARE NOT TO BE USED FOR THE ESTABLISHMENT OF PROPERTY LINES OR FOR THE ESTABLISHMENT OF ANY PROPOSED CONSTRUCTION UNLESS SAID CONSTRUCTION IS SHOWN HEREON.

THIS PLAN WAS PREPARED FOR THE EXCLUSIVE USE AND PURPOSE FOR THE PARTY STATED HEREON AND SHALL NOT BE USED BY ANY THIRD PARTY WITHOUT THE EXPRESSED WRITTEN PERMISSION OF GUERRIERE AND

CONSTRUCTION ON THIS LAND IS SUBJECT TO ANY EASEMENTS, RIGHTS-OF-WAY, RESTRICTIONS, RESERVATIONS, OR OTHER LIMITATIONS WHICH MAY BE REVEALED BY AN EXAMINATION OF THE TITLE.

CONTRACTORS (IN ACCORDANCE WITH MASS.G.L. CHAPTER 82 SECTION 40 AS AMENDED) MUST CONTACT ALL UTILITY COMPANIES BEFORE EXCAVATING AND DRILLING AND CALL DIGSAFE AT 1(888)DIG-SAFE{7233}.

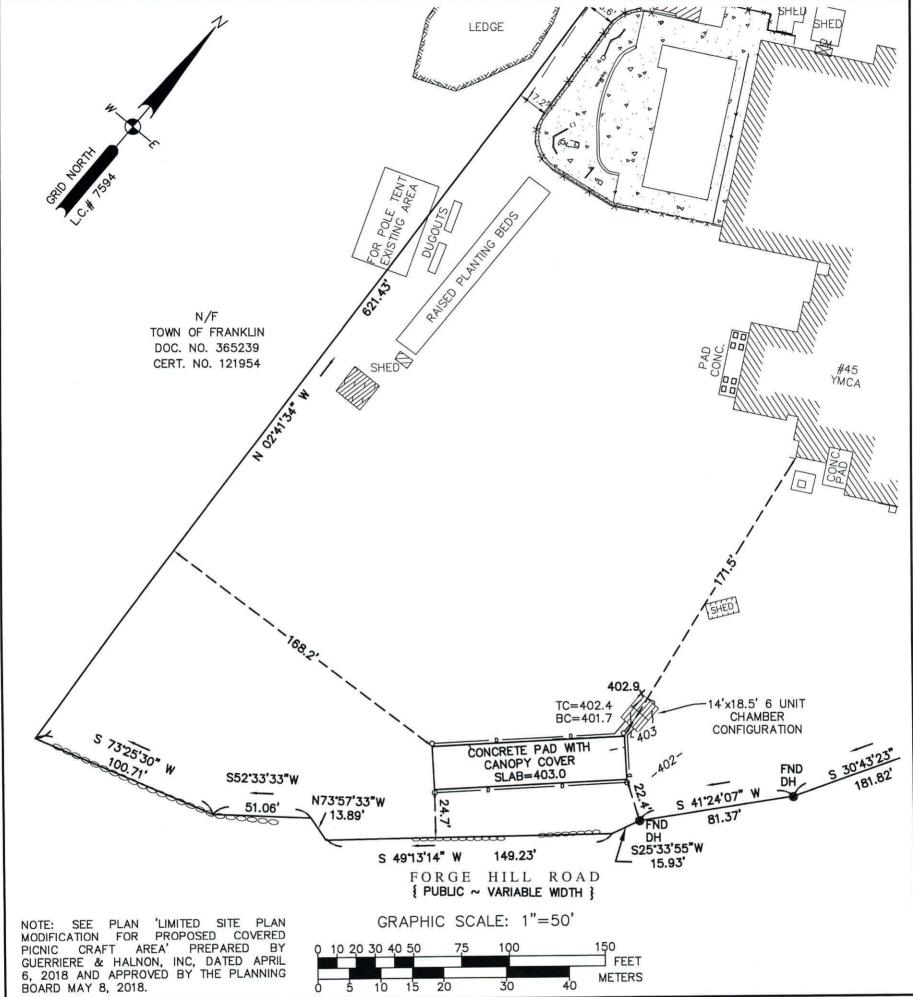

I CERTIFY THAT THIS PLAN WAS PREPARED FROM AN ON THE GROUND SURVEY AND THAT THE FEATURES AND IMPROVEMENTS ARE LOCATED ON THE LOT AS SHOWN HEREON.

CERTIFICATION



## OWNER

HOCKOMOCK AREA YMCA C/O KEVIN DIONNE 45 FORGE HILL ROAD FRANKLIN, MA 02038

## HOCKOMOCK AREA YMCA

SITE AS-BUILT
FOR
45 FORGE HILL ROAD
FRANKLIN
MASSACHUSETTS

DATE: MARCH 24, 2021



# Guerriere & Halnon, Inc.

ENGINEERING & LAND SURVEYING

55 WEST CENTRAL ST. PH. (508) 528-3221 FRANKLIN, MA 02038 FX. (508) 528-7921 www.gandhengineering.com

## SITE PLAN OF LAND

# FORM H ENGINEER'S CERTIFICATE OF COMPLETION

(to be executed by developer's engineer)

Site Plan known as Limited Site Plan Modification for Proposed Covered Picnic Craft Area

	have been completed in all respects requirements and the approved plan prepared by Guerriere & Halnon, Inc.	nts required for the above referenced site plan s in accordance with the Town of Franklin zoning ns entitled Limited Site Plan Modification for Proposed Covered Picnic Craft Are and dated **April 6, 2018, as approved by  ** Revised thru May 8, 2018
IV	Signed this 25th  By Wall Mark	day of March, 2021 Reg. C.E.
No	COMMONWEA	LTH OF MASSACHUSETTS  March 15, 2021
unde (nam were	On this 25 <sup>th</sup> day of March rsigned notary public, personally app	2021, before me, the eared Dale Machington satisfactory evidence of identification, which to be the person whose name is signed on the
	AMANDA K. CAVALIERE  Notary Public  COMMONWEALTH OF MASSACHUSETTS	Official signature and seal of notary)  Notary Public:  My Commission Expires: Nov. 14, 2025



# TOWN OF FRANKLIN - SITE OBSERVATION REPORT 45 Forge Hill Road

Report No.: 4831 74 - 4 Date: March 31, 2021 Arrive: 10:15 AM

Observer: Matt Crowley, PE Weather: Cloudy, 55° Leave 10:30 AM

Owner: YMCA Contractor: Unknown

45 Forge Hill Road Franklin, MA 02038

Items Observed: Conformance Observation – Submitted in conjunction with

Applicant's request for acceptance of Form H - Certificate of Completion

#### **OBSERVATIONS**

**Observation Requested By:** Amanda Cavaliere – Guerriere and Halnon, Inc.

Met/walked site with: N/A

Current Activity on Site: No current activity

**Observed Construction:** BETA arrived on site to perform a construction observation in conjunction with the Applicant's request for acceptance of Form H – Certificate of Completion. The required Form H and as-built plan, both dated March 25, 2021, were provided by email. BETA's site walk and review of the Approved Plans confirmed the site to be constructed in general conformance with the Approved Plans and approved field changes. BETA notes that while the approved plans do not indicate the method for restoring disturbed surfaces, it is anticipated that loam and seed will be applied when conditions are suitable for growing grass.



Installed concrete pad with canopy



Typical roof leader directed to subsurface infiltration system



2 of 3

45 Forge Hill Road Site Observation Report No. 4 March 31, 2021



Disturbed area that is anticipated to have loam and seed installed during the grass growing season.



3 of 3





355 EAST CENTRAL STREET FRANKLIN, MA 02038-1352 TELEPHONE: 508-520-4907

Fax: 508-520-4906

#### **MEMORANDUM**

**DATE:** March 31, 2021

**TO:** Franklin Planning Board

FROM: Department of Planning and Community Development


**RE:** 45 Forge Hill - YMCA


Final Form H

## **General**

1. The Planning Board approved a Limited Site Plan Modification on May 7, 2018 allowing the applicant to install a covered concrete slab to be used as a picnic area.

- 2. The Applicant has provided a Final Form H and Final As-Built plan.
- 3. BETA has provided an onsite report with pictures.

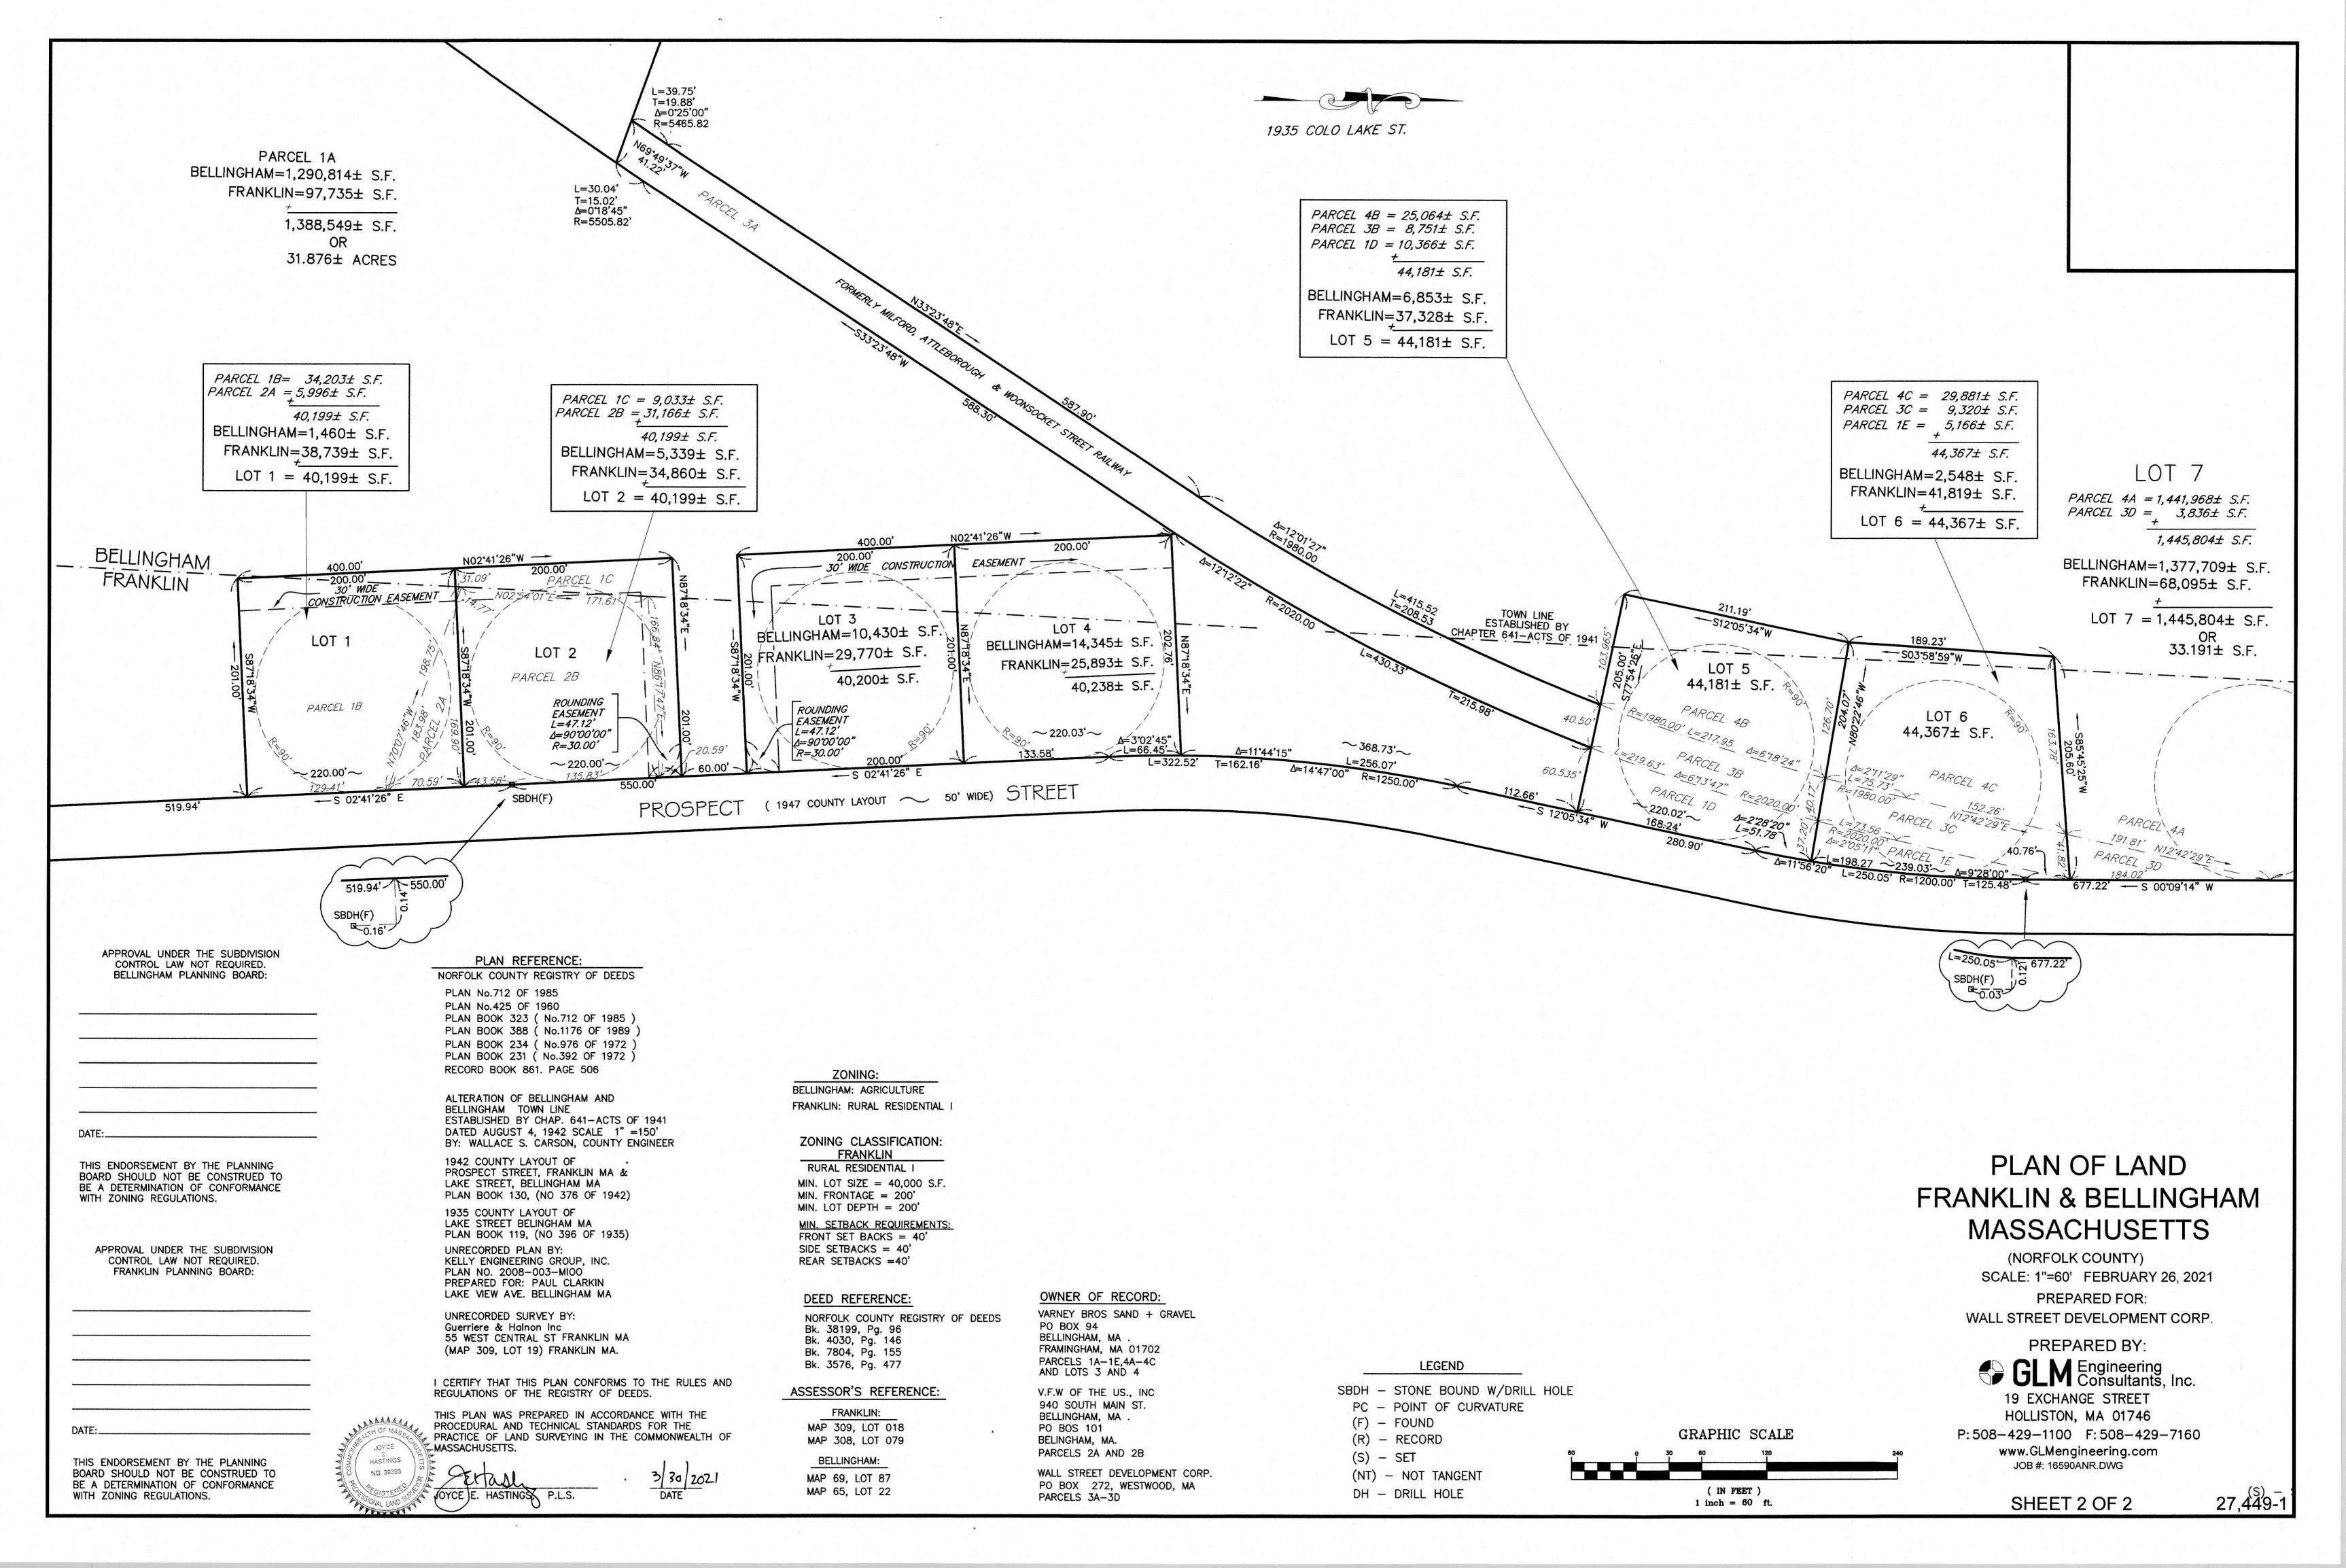

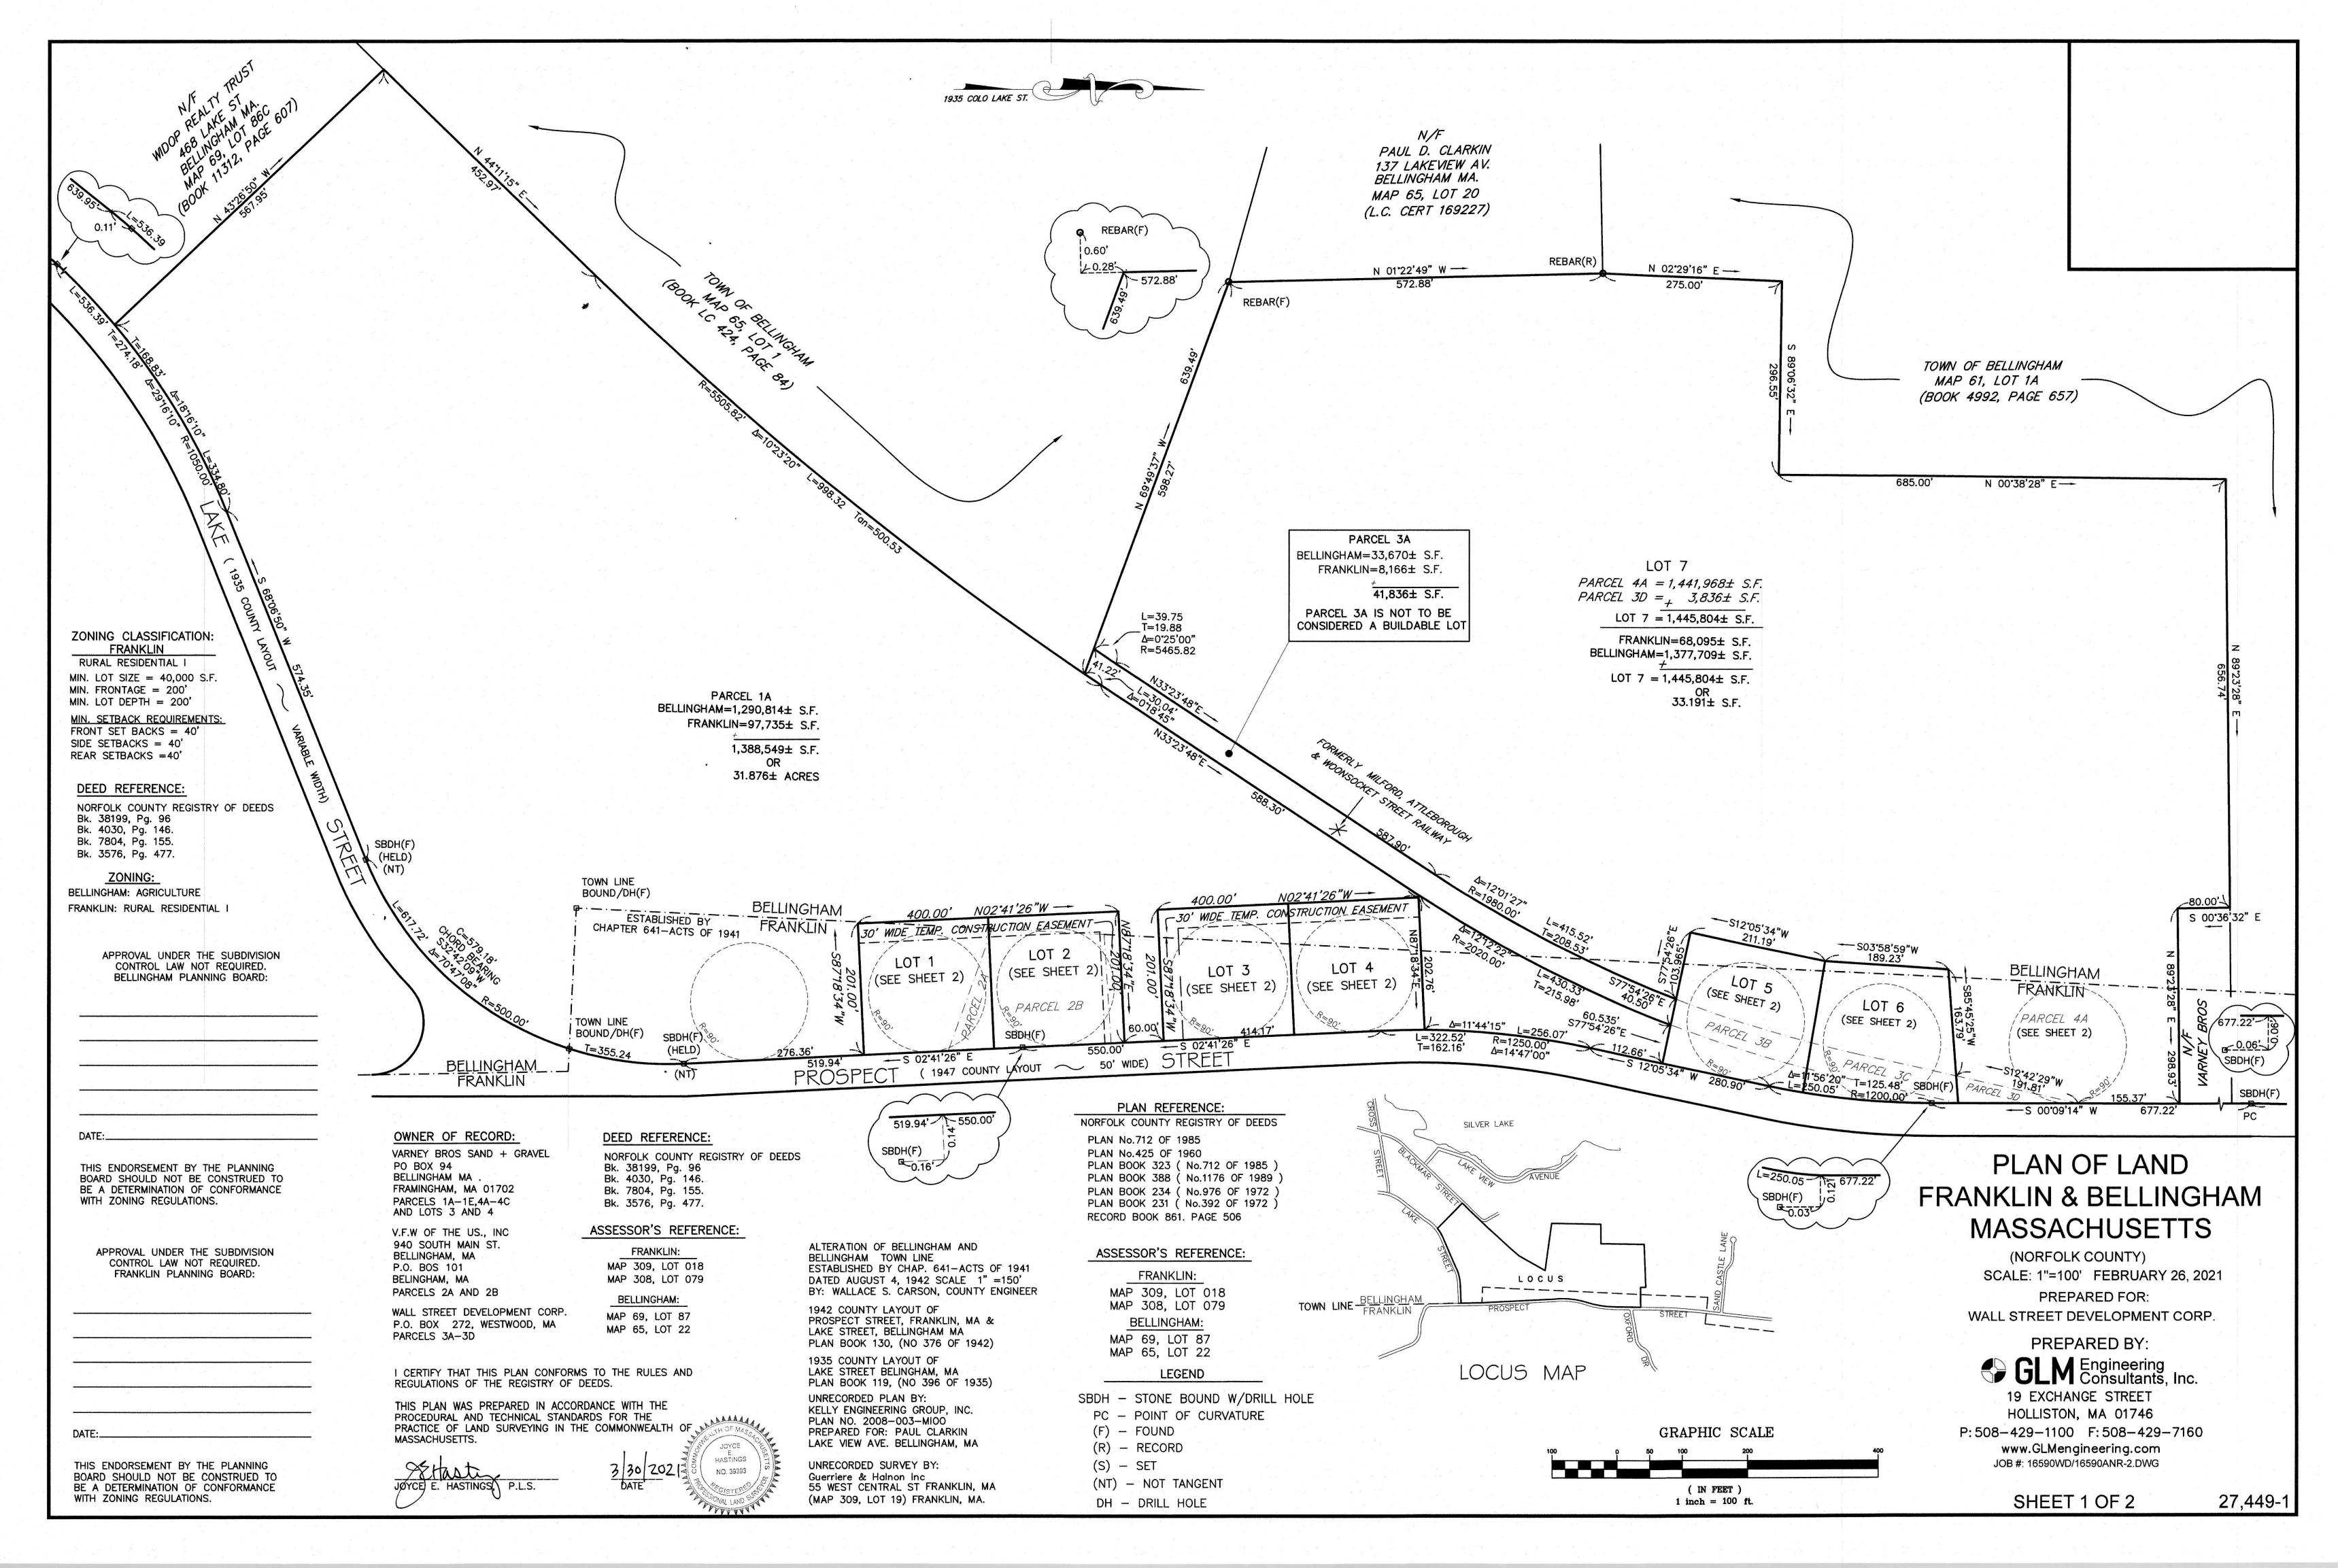

## FRANKLIN PLANNING & COMMUNITY DEVELOPMENT



355 EAST CENTRAL STREET FRANKLIN, MA 02038-1352 TELEPHONE: 508-520-4907

Fax: 508-520-4906

#### **MEMORANDUM**

**DATE:** March 30, 2021

TO: Franklin Planning Board

FROM: Department of Planning and Community Development

**RE:** 81-P ANR – Prospect St

The DPCD has reviewed the above referenced 81-P (ANR) application for the Monday, April 5, 2021 Planning Board meeting and offers the following commentary:

## General

- 1. The applicant has submitted a Form A application for 81-P Plan Review to accompany the plan of land for Franklin & Bellingham located on Prospect Street, dated February 26, 2021.
- 2. The purpose of the plan is to create 6 buildable lots.
- 3. The above application shows the land known on Assessors Map 309 Lot 018 and Map 308 Lot 079.

## **ANR Summary**

• The lots shown on the plan are conforming to zoning.

## PLANNING BOARD FRANKLIN, MASSACHUSETTS

## FORM A

## APPLICATION FOR ENDORSEMENT OF PLAN BELIEVED NOT TO REQUIRE APPROVAL (81-p)

March 29, 2021

To the Planning Board of the Town of Franklin, Massachusetts:
The undersigned, believing that the accompanying plan of land in the Town of Franklin does not constitute a subdivision within the meaning of the Subdivision Control Law, for the reason outlined below, herewith submits said plan for a determination and endorsement that Planning Board approval under the Subdivision Control Law is not required.
1. Name of Applicant: WALL Street Development Corp.  Address of Applicant: P.O. Box 272 Westwood, MA 0 2090  Phone No.: 617-922-8700 Email: 104 @ WALLStreet development.com
2. Name of Owner (if not the Applicant):
3. Name of Engineer: GLM Engineering Consultants, Inc. 20009 440
3. Name of Engineer: GLM Engineering Consultants, Inc. 38899 440 4. Deed of Property recorded inwith Norfolk Registry, Book 39199, Page 96
5. Location and Description of Property: VACANE LAND
6. Assessor's Map & Lot: N/A
<ul> <li>Reasons approval is not required (check as applicable):</li> <li>a) Every lot shown has the area and frontage required by the Zoning By-Law on a way as defined by the Subdivision Regulations</li> </ul>
b) a public way or way which the Town Clerk certifies is maintained and used as a public way, namely Prospect Street, or
c) a way shown on a plan theretofore approved and endorsed in accordance with the subdivision control law namely on, and subject to the following conditions; or
d) a private way in existence on March 12, 1954, the date when the subdivision control law became effective in the Town of Franklin having, in the opinion of the Planning Board, sufficient width, suitable grades, and adequate construction to provide for the needs of vehicular traffic in relation to the proposed use of the land abutting thereon or served thereby, and for the installation of municipal services to serve such land and the buildings erected or to be erected thereon,  namely
e) Other:
Signature of Applicant  Signature Owner

Wall Street Development Corp. Wall Street Development Corp.
Print Name of Applicant Print Name of Owner

## PLANNING BOARD FRANKLIN, MASSACHUSETTS

## FORM A

APPLICATION FOR ENDORSEMENT OF PLAN BELIEVED NOT TO REQUIRE APPROVAL (81-p)

March 29 , 20 21
To the Planning Board of the Town of Franklin, Massachusetts:
The undersigned, believing that the accompanying plan of land in the Town of Franklin does not constitute a subdivision within the meaning of the Subdivision Control Law, for the reason outlined below, herewith submits said plan for a determination and endorsement that Planning Board approval under the Subdivision Control Law is not required.
1. Name of Applicant: WALL Street Development CORP.  Address of Applicant: P.O. Box 272, Westwood, MA 02090  Phone No.: 617-972-8700 Email: Lou @ Wallstreetdevelopment COM
2. Name of Owner (if not the Applicant): V.F.W. Bellingham Post 7272  Address of Owner: 940 S. Main Street, Bellingham, MA 02019  Phone No.: Email:
3. Name of Engineer: GLM Engineering Consultants, Inc.
4. Deed of Property recorded in 1968 with Norfolk Registry, Book 4499, Page 544
5. Location and Description of Property: Rospect Street
6. Assessor's Map & Lot: 309 - 019 - 000 - 000
<ul> <li>Reasons approval is not required (check as applicable):</li> <li>a) Every lot shown has the area and frontage required by the Zoning By-Law on a way as defined by the Subdivision Regulations</li> </ul>
b) a public way or way which the Town Clerk certifies is maintained and used as a public way, namely PROS pect Street, or
c) a way shown on a plan theretofore approved and endorsed in accordance with the subdivision control landar namely on, and subject to the following conditions; or
d) a private way in existence on March 12, 1954, the date when the subdivision control law became effective in the Town of Franklin having, in the opinion of the Planning Board, sufficient width, suitable grades, and adequate construction to provide for the needs of vehicular traffic in relation to the proposed use of the land abutting thereon or served thereby, and for the installation of municipal services to serve such land and the buildings erected or to be erected thereon, namely
e) Other:
Signature of Applicant Signature Owner 2/15/21
Wall Street Development CORR V.F.WBellingham Post Print Name of Applicant Print Name of Owner Lows Petrozzi, President Patrick Pisani, Commander

## PLANNING BOARD FRANKLIN, MASSACHUSETTS

## FORM A

APPLICATION FOR ENDORSEMENT OF PLAN BELIEVED NOT TO REQUIRE APPROVAL (81-p)

March 29 , 20 21

To the Planning Board of the Town of Franklin, Massachusetts:
The undersigned, believing that the accompanying plan of land in the Town of Franklin does not constitute a subdivision within the meaning of the Subdivision Control Law, for the reason outlined below, herewith submits said plan for a determination and endorsement that Planning Board approval under the Subdivision Control Law is not required.
1. Name of Applicant: WALL Street Development Corp. Address of Applicant: P.O. Box 272, Westwood, MA 02690 Phone No.: 617-922-8700 Email: 104 @ WALLStreet development. GOH
2. Name of Owner (if not the Applicant): VARNEY RROS. SAND + GRAVEL, INC.  Address of Owner: P.O. BOX 94, Bellingham, MA 02019  Phone No.: 508-966-1313 Email: IVARNEY@ VARNEY PROPERTIES. COM
3. Name of Engineer: GLM ENGINEERING CONSULTANTS, INC.
4. Deed of Property recorded inwith Norfolk Registry, Book, Page
5. Location and Description of Property: PROSPECT STREET
6. Assessor's Map & Lot: 309-018-000-000 And 308-079-000-000
<ul> <li>Reasons approval is not required (check as applicable):</li> <li>a) Every lot shown has the area and frontage required by the Zoning By-Law on a way as defined by the Subdivision Regulations</li> </ul>
b) a public way or way which the Town Clerk certifies is maintained and used as a public way, namely Prospect 5+ ret, or
c) a way shown on a plan theretofore approved and endorsed in accordance with the subdivision control law namely on, and subject to the following conditions; or
d) a private way in existence on March 12, 1954, the date when the subdivision control law became effective in the Town of Franklin having, in the opinion of the Planning Board, sufficient width, suitable grades, and adequate construction to provide for the needs of vehicular traffic in relation to the proposed use of the land abutting thereon or served thereby, and for the installation of municipal services to serve such land and the buildings erected or to be erected thereon, namely
e) Other:
Signature of Applicant Signature Owner
WAIL Street Development CORP. VARNEY BROS. SAND & GRAVEL, INC.  Print Name of Owner  Louis Petrozzi, President Elizabeth VARNEY, President

3/28/2021 \$ \*\*350.00 53-7353/2113 Needham Bank 6 B B A WALL STREET DEVELOPMENT CORP.
P.O. BOX 272
WESTWOOD, MA 02090-0272
TEL. (781) 440-0306 Varney Property - ANR Plan Franklin - Town of 355 East Central Street Franklin, MA 02038 Franklin - Town of PAY TO THE ORDER OF MEMO

DOLLARS
Security features. Details on back.

Œ

5902597111

#O14855# #211373539#

## CERTIFICATE OF OWNERSHIP

I the undersigned Applicant, do hereby certify to the Town of Franklin, through its Planning Board, that all parties of interest to the below-listed plan are identified in Section B: below,

C	17	~	ויד	$\sim$	<b>x</b> 1	A	
	г.	ι.	1 8	1 1	N	А	٠
=	_	<u>~</u>		$\sim$	4.4	1 L	٠

Type of Plan	(circle	one)	i
--------------	---------	------	---



Preliminary Subdivision

Definitive Subdivision.; Site Plan;

Special Permit

Title of Plan: Plan of Land Franklin & Bellingham, Massachusetts

Date of Plan: February 26, 2021

Map/Parcel#: 309-018-000-000

Map/Parcel#: 308-079-000-000

Prepared by: GLM Engineering Consultants, Inc., 19 Exchange Street, Holliston, MA 01746

Applicant Name & Address: Wall Street Development Corp., P.O. Box 272, Westwood, MA 02090

## SECTION B:

Name of Record Owner(s): Varney Bros. Sand & Gravel, Inc.

Address of Record Owner(s): P.O. Box 94, Bellingham, MA 02019

**Attach Property Deed matching the owner	er's	name listed above.
---	------	--------------------

\*If in the name of a Trust, Corporation or Partnership, list the names and addresses of all Trustee(s), Corporate Officer(s) or Partner(s):

See Attached.

\*If in the name of a Trust or Corporation, list the Beneficiary(ies) of the Trust or the Shareholder(s) of the Corporation:

\*If in the name of a Trust or Corporation, list the date, county, book and page of recording of the Trust Instrument, or the date and State of incorporation:

Executed as a sealed instrument this

day of March, 2021.

Wall Street Development Corp.

Print Name of Applicant

Signature of Owner

Varney Bros. Sand & Gravel, Inc.

Print Name of Owner

<sup>\*\*\*</sup>Must be Notarized on back page

## COMMONWEALTH OF MASSACHUSETTS

) · · · · · · · · · · · · · · · · · · ·	AMONWEALTH OF WASSACHUSETTS
MORTOLK_ss.	March <u>222</u> 2021
On this 22 day of March, 2021, FLIZAB ON A ANN YOR ME evidence of identification, which wer preceding document in my presence.	before me, the undersigned notary public, personally appeared (name of owner), proved to me through satisfactory to be the person whose name is signed on the (Official signature and seal of notary)  Notary Public:  My Commission Expires: 6-28 24
	Laura Ann Renaud  NOTARY PUBLIC  Commenwealth of Massachusetts  My Commission Expires June 28, 2024

## **Corporations Division**

## **Business Entity Summary**

ID Number: 042134961 Request certificate New search

**Summary for: VARNEY BROS. SAND & GRAVEL, INC.** 

The exact name of the Domestic Profit Corporation: VARNEY BROS. SAND & GRAVEL,

INC.

**Entity type:** Domestic Profit Corporation

**Identification Number:** 042134961

**Date of Organization in Massachusetts:** 

12-31-1951

Last date certain:

Current Fiscal Month/Day: 12/31 Previous Fiscal Month/Day: 12/31

The location of the Principal Office:

Address: 79 HARTFORD AVE.

City or town, State, Zip code, BELLINGHAM, MA 02019 USA

Country:

The name and address of the Registered Agent:

Name: JON R. VARNEY

Address: 79 HARTFORD AVE.

City or town, State, Zip code, BELLINGHAM, MA 02019 USA

Country:

#### The Officers and Directors of the Corporation:

Title	Individual Name	Address
PRESIDENT	ELIZABETH A. VARNEY	1335 WALNUT ST. NEWTON, MA 02461 USA
TREASURER	ELIZABETH A. VARNEY	1335 WALNUT ST. NEWTON, MA 02461 USA
SECRETARY	BARTHOLOMEW P. MOLLOY	20 YORK WAY, WESTWOOD, MA 02090 USA
DIRECTOR	JANE W. ELLIS	79 BATES ST. MENDON, MA 01756 USA
DIRECTOR	BARTHOLOMEW P. MOLLOY	20 YORK WAY WESTWOOD, MA 02090 USA
DIRECTOR	ELIZABETH A. VARNEY	1335 WALNUT ST. NEWTON, MA 02461 USA
DIRECTOR	JON R. VARNEY	78 BELLINGHAM ST. MENDON, MA 01756 USA

#### **Business entity stock is publicly traded:**

The total number of shares and the par value, if any, of each class of stock which this business entity is authorized to issue:

O P YNUS CO P YN	量√量 C'GP Y
MAN STANKER ST	XXXXXXXXXXXXXXXXXXXXXXXXXXXXXXXXXXXXXXX
Bifness my hand and seal this	24th day of June, 19 57.
e e e e e e e e e e e e e e e e e e e	3 ella 71/. Chase
and the second s	<u> </u>
The Commonwi Norfolk	June 24,
Then personally appeared the above-named	
and acknowledged the foregoing instrument to be	her reactand deed, before me  **********************************
Recorded July	25.1957 at 35 22 5 4

That I Ellsworth R. Crooks

of Bellingham, Norfolk

County, Massachusetts,

of Bellingham Massachusetts

with quttelaim covenants

the land in said Bellingham described as follws: being all the premises described in deed of Almira E. Chilson, a sadministratrix of the estate of WhippleO. Chilson, to said Judson E. Canp. dated June 5, 1893 recorded with with Norfolk Deeds Book 721, Page 178, and described in part of said Bellingham, containing 43 acres and 65 sq. rods and the southerly bounded and described as follows, viz. Peginning at the N.E. corner of prospect St. thence by and upon said St. S. 12°W. 580 ft 8. 22°W 308 ft. and stones at land of Joel A. and Geo. A. Trooks, thence in wesperly at land ofGeo A. Crooks land N. 60°W. 1260 ft. to a stake and stones at land of Joel A. and Geo. A. Trooks, thence in same general of said Wm. and Mayhew Darling to a stake and stones at a corner of land of Said Wm. and Mayhew Darling N 8° 30°E 275 ft on land of Edwin Darling: thence on land of said Edwin Darling S 77°E. 315 ft. to a stake and stones at a corner of land to a corner; thence still on said Edwin Darling land N. 12°45 ft. 685 ft. to a stake and stones at the point of departure. Meaning to convey all of the above and attleboro St. Railway Company by Judson E. Camp, and a small parcel also subject to easements granted to the Town of Franklin fradrainage to change in Town lines between Franklin and Bellingham. For my title

	bushard of said grantor wife
Ellsworth R. Crooks	wife of said grantor
release to said grantee all rights of dower and	homestead and other interests therein.
Biliness their hand I and seal I this	8 th day of September 19.56
	Elleworth RCros
p	Corona (sooks)
,,,,,,,,,,,,,,,,,,,,,,,,,,,,,,,,,,,,,,	
The Commonwes	elth of Museachusetts
Norfolk SS.	September 8
Then personally appeared the above nam	ed. Ellsworth R. Crooks and Corona
***************************************	***************************************
and acknowledged the foregoing instrument to	

We, JAMES J. WHITE, SR., and VICLA M. WHITE (husband and wife),

of Bellingham, Hassachusetts.

with warranty covenants,

the land in BELLINGHAM, Norfolk County, Massachusetts, described as follows:
(Description and oncumbrances, if any)

Those certain parcels of land laid out and designated as lots numbered 132, 133, 134, and 166, 167, on a plan of land entitled "Charles River Grove", dated March 1919, and recorded with the Norfolk Registry of Deeds, Plan Book 89, Plan 4344, to which reference may be had for a more particular description.

Maning to convey and hereby conveying the same premises conveyed to these grantors by deed of Florence Woodman, dated August 11, 1956, and recorded Book 3497, Page 200.

N **146**0 F F Ι C IAL

> Ρ Y

Ι C Ι ΑL С 0 Ρ

0 Charles E. Spooner, Jr. and Howard C. Abbott

EXECUTOR Sudder the WILL of — ADDITION TO THE CONTROL OF THE CONTR

Will L. Grooks, late of Fellingham, Norfolk County, Massachusetts, decessed by power conferred by seld will (Norfolk Probate No. 152750)/by license from said Norfolk Probate Court dated April 2h, 1962 and

and every other power, Dollars Seven Thousand (\$7,000.00) paid grant to Verney Pros. Sand & Gravel, Inc., a Massachusetts corporation with a mincipal place of business in Fellingham, Massachusetts the land in the southerly part of said Fellingham lying so theast of the M. A. & M. St. R'y and bounded as follows; beginning at the southeast corner at land of George Christic and running S. 63° 7' E. 25 rods 2 links to a stake; thence westerly on land of said George Christic to said Street Railway; thence along land of said Railway to land of Judien E. Camp, formerly owned by Whiptle C. Chilson; thence 62° E. on land of said Camp to a corner of the wall on Prospect Street; thence S. 7° [5] E. on said wall 35 rods more or less, to a point expessite a stone bound on the line between the towns of Lillingham and Franklin; thence southwesterly partly on a ditch 30 rods, more or less to the east side of saw mill trench; thence westerly across said trench to the tenk wall on west side of same; thence southwest on said bank, back of saw-mill to a stone bridge on Lake St. thence southwest on said street 60 rods, more or less to the first mentioned corner. Also the Mill privilege for a description of which reference is made to a deed recorded in Dedham Apr. 30th 1860 Lib. 287 folio E0.

Also a tract of land sdjoining the last mentioned tract, situated on the west side of Prospect St. and north side of Lake St. containing three acres more or less, bounded as follows: leginning at the stone bound between Tellin, here & Franklin on Prospect St. at the northeast corner, thence running Wasterly partly on a ditch 32 rods to the east side of the dam; thence b rods and 30 links on the trench to a small white oak tree; thence southerly 10 rods and 1 links to Lake Street thence easterly on said St. to Prospect Lt. thence northerly on Prospect St. to the first mentioned bound.

Excepting therefrom the land conveyed to Chester F. Crooks et ux by Will L. Crooks by deed duly recorded with Norfolk Deeds Lock 3733, Page 37 paid, grant to Verney Eros. Sand & Gravel, Inc., a Massachusetts corporation with a principal place of business in Eellingham, Massachusetts

Excepting therefrom the land conveyed to Chester F. Crooks et ux by Will L. Crooks by deed duly recorded with Norfolk Deeds Lock 3733, Page 370. Also any land taken for the relocation of Lake Street. A portion of the sforesaid and is now situated in Franklin as a result of relocation of the town line.







#itness927 hand pand scale this 29	th day of October 1062
	Charles E Sonon 1
and the state of t	xecutors w/w Hill L. Croft
	Executors dyn hill L. CHCOKS

The Commonwealth of Massachusetts

Norfolk

October 29, 1962

Then personally appeared the above named Howard C. Abbott

and acknowledged the foregoing instrument to be his free act and deed, before me

DEED CAMUELLED HOV - 245

Jama B. Cetals

## CERTIFICATE OF OWNERSHIP

I the undersigned Applicant, do hereby certify to the Town of Franklin, through its Planning Board, that all parties of interest to the below-listed plan are identified in Section B: below,			
SECTION A:			
Type of Plan (circle one)  ANR 81-P: Preliminary Subdivision			
Definitive Subdivision.; Site Plan; Special Permit			
Title of Plan: Plan of Land Franklin & Bellingham, Massachusetts			
Date of Plan: February 26, 2021 Map/Parcel#: N/A			
Prepared by: GLM Engineering Consultants, Inc., 19 Exchange Street, Holliston, MA 01746			
Applicant Name & Address: Wall Street Development Corp., P.O. Box 272, Westwood, MA 02090			
SECTION B:			
Name of Record Owner(s): Wall Street Development Corp.			
Address of Record Owner(s): P.O. Box 272, Westwood, MA 02090			
**Attach Property Deed matching the owner's name listed above.			
*If in the name of a Trust, Corporation or Partnership, list the names and addresses of all Trustee(s), Corporate Officer(s) or Partner(s):			
Louis Petrozzi, President & Treasurer			

\*If in the name of a Trust or Corporation, list the Beneficiary(ies) of the Trust or the Shareholder(s) of the Corporation:

\*If in the name of a Trust or Corporation, list the date, county, book and page of recording of the Trust Instrument, or the date and State of incorporation:

Massachusetts - 1995

Executed as a sealed instrument this 25<sup>th</sup> day of March, 2021.

Wall Street Development Corp.

Print Name of Applicant

Wall Street Development Corp.

Print Name of Owner

## **COMMONWEALTH OF MASSACHUSETTS**


Norfolk, SS.

March 25, 2021

On this 35 day of March, 2021, before me, the undersigned notary public, personally appeared Louis Petrozzi, proved to me through satisfactory evidence of identification, which was a Massachusetts Driver's License, to be the person whose name is signed on the preceding or attached document, and acknowledged to me that he signed it voluntarily for its stated purpose as his own free act and deed, as President and Treasurer for Wall Street Development Corp., a corporation and who swore or affirmed that the contents of the document are truthful and accurate to the best of their knowledge and belief.

Notary Public: Mal J Blow
Printed Name:

My Commission Expires:

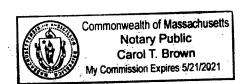

## **QUITCLAIM DEED**

I, Walter H. Sawyer, Jr., Personal Representative of the Estate of Constance C. Sawyer, Norfolk Probate Court Docket No. NO20P2282EA, of North Smithfield, Rhode Island conferred by Power of Sale in Will allowed by Norfolk Probate Court, Docket No. NO20P2282EA, dated January 8, 2021 and every other power for consideration paid of Twelve Thousand Five Hundred Dollar and No Cents (\$12,500.00), grants to Wall Street Development Corp. a Massachusetts corporation with an address at P.O. Box 272, Westwood, Massachusetts, with QUITCLAIM COVENANTS, the land in the Town of Bellingham and Franklin, Norfolk County, Commonwealth of Massachusetts described as follows:

All my right, title and interest in a certain piece or parcel of land in Bellingham and Franklin, in the county of Norfolk forty (40) feet in width, bounded and described as follows, viz:

Beginning at a point in the division line between land formerly of J.A. C.F. & C.A. Crooks and land formerly of Judson E. Camp and running by a curve to the left of five thousand four hundred and sixty five and eighty two hundredths (5465.82) feet radius forty (40) feet;

thence north 45° 06′ 40″, east by a tangent five hundred and eighty eight and three tenths (588.3) feet;

thence by a curve to the left of one thousand nine hundred and eighty (1980) feet radius seven hundred and nine (709) feet;

thence north 24° 58' 28" east by a tangent three hundred and ninety eight and four hundredths (389.04) feet to a point on the westerly side line of the highway between Woonsocket and Franklin;

thence turning and running south 12° 06' west along said westerly line one hundred and eighty five and five hundredths (185.05) feet;

thence south 24° 35' 20" west two hundred and seventeen and thirty six hundredths (217.36) feet;

thence by a curve to the right of two thousand and twenty (2020) radius seven hundred and twenty three and thirty three hundredths (723.33) feet;

thence south  $45^{\circ}$  06' 40'' west by a tangent five hundred and eighty eight and three tenths (588.3) feet;

thence by a curve, to the right of five thousand five hundred and five and eighty two hundredths (5505.82) feet radius thirty (30) feet to a point on the division line between land formerly of J.A. C.F. and C.A. Crooks, and land formerly of Judson E. Camp;

thence north 58° west along said division line forty one and five hundredths (41.05) feet to the point of beginning and containing sixty five thousand eight hundred and eighty six (65,886) square feet +/- of land. All as shown on a plan entitled "Land conveyed by S.C. Camp Bellingham, Mass. Scale 1=100' "dated July 18, 1899 drawn by Hodges and Harrington Civil Engineers 60 State St. Boston and recorded with the Norfolk Registry of Deeds in Book D0861, Page 506.

Being the same premises conveyed to Ellsworth R. Crooks by Treasurer's deed of the Town of Bellingham dated January 11, 1945 and recorded with Norfolk Registry of Deeds in Book 2526, page 128. Excepted therefrom conveyance to Varney Bros. Sand and Gravel, Inc., by Ellsworth R. Crooks recorded with Norfolk Registry of Deeds in Book 3576, page 477. See also Norfolk County Probate records Estate of Ellsworth R. Crooks Docket No. 83F1397A1 and Estate of Constance C. Sawyer Docket No. 20P2282EA. WITNESS my hand and seal this 14 day of JANUARY

of the Estate of Constance C. Sawyer and not individually

STATE OF RHODE ISLAND

SROVINANCE, SS

1/14/,2021

evidence of identification which was his Driver's License, to be the persons whose name are signed on the preceding or attached document, and acknowledged the foregoing to be signed by him/her voluntarily for its stated purpose and who swore or affirmed to me that the contents of the document are truthful and accurate to the best of his/hen/showledge and belief.

Return To:

Return To:

### **QUITCLAIM DEED**

I, Bertine C. Galipeau of 60 North Road, Montgomery, Massachusetts ("Grantor"), for consideration paid and in full consideration of Ten Thousand Dollar and No Cents (\$10,000.00), grants to Wall Street Development Corp. a Massachusetts corporation with an address at P.O. Box 272, Westwood, Massachusetts, with QUITCLAIM COVENANTS, the land in the Town of Bellingham and Franklin, Norfolk County, Commonwealth of Massachusetts described as follows:

All my right, title and interest in a certain piece or parcel of land in Bellingham and Franklin, in the county of Norfolk forty (40) feet in width, bounded and described as follows, viz:

Beginning at a point in the division line between land formerly of J.A. C.F. & C.A. Crooks and land formerly of Judson E. Camp and running by a curve to the left of five thousand four hundred and sixty five and eighty two hundredths (5465.82) feet radius forty (40) feet;

thence north 45° 06' 40", east by a tangent five hundred and eighty eight and three tenths (588.3) feet:

thence by a curve to the left of one thousand nine hundred and eighty (1980) feet radius seven hundred and nine (709) feet;

thence north 24° 58' 28" east by a tangent three hundred and ninety eight and four hundredths (389.04) feet to a point on the westerly side line of the highway between Woonsocket and Franklin;

thence turning and running south 12° 06' west along said westerly line one hundred and eighty five and five hundredths (185.05) feet;

thence south 24° 35' 20" west two hundred and seventeen and thirty six hundredths (217.36) feet;

thence by a curve to the right of two thousand and twenty (2020) radius seven hundred and twenty three and thirty three hundredths (723.33) feet;

thence south 45° 06′ 40" west by a tangent five hundred and eighty eight and three tenths (588.3) feet;

thence by a curve, to the right of five thousand five hundred and five and eighty two hundredths (5505.82) feet radius thirty (30) feet to a point on the division line between land formerly of J.A. C.F. and C.A. Crooks, and land formerly of Judson E. Camp;

thence north 58° west along said division line forty one and five hundredths (41.05) feet to the point of beginning and containing sixty five thousand eight hundred and eighty six (65,886) square feet +/- of land. All as shown on a plan entitled "Land conveyed by S.C. Camp

Fee: \$45.60 Cons: \$10,000.00

Bellingham, Mass. Scale 1=100' "dated July 18, 1899 drawn by Hodges and Harrington Civil Engineers 60 State St. Boston and recorded with the Norfolk Registry of Deeds in Book D0861, Page 506.

Being the same premises conveyed to Ellsworth R. Crooks by Treasurer's deed of the Town of Bellingham dated January 11, 1945 and recorded with Norfolk Registry of Deeds in Book 2526, page 128. Excepted therefrom conveyance to Varney Bros. Sand and Gravel, Inc., by Ellsworth R. Crooks recorded with Norfolk Registry of Deeds in Book 3576, page 477. See also Norfolk County Probate records Estate of Ellsworth R. Crooks Docket No. 83F1397A1 and Estate of Corona Crooks Docket No. 20P1129EA.

Grantor, Bertine C. Galipeau, hereby releases and relinquishes any and all rights of homestead in the within premises and further state under the pains and penalties of perjury that no other person have the right to claim homestead benefits in said property.

WITNESS my hand and seal this Aiday of July, 2020.

Bertine Of Mepine Bertine C. Galipeau

COMMONWEATLH OF MASSACHUSETTS

Humpden iss

July 2, 2020

My Commission Expires July 19 DO24

On this 2<sup>nd</sup> day of July 2020, before me, the undersigned notary public, personally appeared Bertine C. Galipeau, who proved to me through satisfactory evidence of identification which was her <u>Driver's License</u>, to be the persons whose name are signed on the preceding or attached document, and acknowledged the foregoing to be signed by him ther voluntarily for its stated purpose and who swore or affirmed to me that the contents of the document are truthful and accurate to the best of his her knowledge and belief.

Return To: Louis Petrozei

P.O. Bux 272

Westwood, MAGROTO

#### CERTIFICATE OF OWNERSHIP

I the undersigned Applicant, do hereby certify to the Town of Franklin, through its Planning Board, that all parties of interest to the below-listed plan are identified in Section B: below,

#### **SECTION A:**

Type of Plan (circle one)

ANR 81-P; Preliminary Subdivision

Definitive Subdivision.;

Site Plan:

Special Permit

Title of Plan: Plan of Land Franklin & Bellingham, Massachusetts

Date of Plan: February 26, 2021

Map/Parcel#: 309-019-000-000

Prepared by: GLM Engineering Consultants, Inc., 19 Exchange Street, Holliston, MA 01746

Applicant Name & Address: Wall Street Development Corp., P.O. Box 272, Westwood, MA 02090

#### SECTION B:

Name of Record Owner(s): V.F.W. - Bellingham Post No. 7272

Address of Record Owner(s): 940 South Main Street, Bellingham, MA 02019

\*\*Attach Property Deed matching the owner's name listed above.

\*If in the name of a Trust, Corporation or Partnership, list the names and addresses of all Trustee(s), Corporate Officer(s) or Partner(s): The Corporation Officers are:

Patrick Pisani, Commander and President, 288 Blackstone St., Bellingham, MA, 02019

Richard R. Hayward, Treasurer, 34 Lakeshore Drive, Bellingham, MA, 02019

Steven G. Shea, Clerk, 1140 S. Main Street, Bellingham, MA, 02019

Marvin C. Ludwig, Director, 118 Glendale Ave., Woonsocket, RI 02895

\*If in the name of a Trust or Corporation, list the Beneficiary(ies) of the Trust or the Shareholder(s) of the Corporation: The Corporation is a non-profit entity with its members as its shareholders

\*If in the name of a Trust or Corporation, list the date, county, book and page of recording of the Trust Instrument, or the date and State of incorporation: Date of Incorporation is 01-17-1972

Executed as a sealed instrument this day of March, 2021. Wall Street Development Corp. Print Name of Applicant V.F.W. - Bellingham Post No. 7272 Print Name of Owner Signature of Owner \*\*\*Must be Notarized on back page COMMONWEALTH OF MASSACHUSETTS Worcester ss. On this /2 day of March, 2021, before me, the undersigned notary public, personally appeared Patrick Pisani, proved to me through satisfactory evidence of identification, which was personal knowledge to be the person whose name is signed on the preceding document in my presence. (Official signature and seal of notary Notary Public: Daniel T Doyle My Commission Expires:8-12-202 COMMONWEALTH OF MASSACHUSETTS March \_\_\_\_, 2021 SS. day of March, 2021, before me, the undersigned notary public, personallyappeared\_ \_\_\_\_\_(name of owner), proved to me through satisfactory \_\_\_\_to be the person whose name is signed on the evidence of identification, which were\_ preceding document in my presence.

(Official signature and seal of notary)
Notary Public:
My Commission Expires:

544

QUITCLANS DEED (INDIVIDUAL) SE

#### I. Hagh Wilson

of Vest Dennis, Barnstable | Donald Nicholson, County, Massachusetts, Aubgranden of Gommander of Bellingham V. F. W Post No. 7272 of South Main Street, Bellingham

of Bellingham, Norfolk County, Massachusetts with quittleim cornents
the landin said Bellingham immediat and Franklin, Norfolk County, Massacuhusetts

## processes and bounded and described as follows:

A certain parcel of land partly in Bellingham and partly in Franklin, both towns located in Norfolk County, and described as fellows:

Beginning at the southeast corner of the granted pranises, at land of Willie L. Crooks on Prospect Street; thence running south 54° 45' west six hundred twenty-five (625) feet on line of fence to a point; thence turning and running north 41° east five hundred seventy (970) feet on land of Ellsworth Crooks to said Prospect Street; thence southeasterly on said street two Hundred fifty (250) feet to point of beginning. Said parcel being triangular in shape and containing one and three-quarters #33%(1 3/4 acres).

Being the same premises conveyed to me by deed of Ellsworth Crooke by deed dated May 7, 1949 and recorded with Norfolk Ragistry of Deeds in Book 2832, Page 315.

SEE PG



REPARK SUPERSTRUCK

THE SHIP HE HAVE AND ALL MEST A

this 8th

me (trit at strandelitimesie	i min was nimite	inimainmental of implifications	
Live Board Striffermierte exchésicom evacemente.	en santa (aliunus de lechter sentien en e	1 HOJLE WI	120
4 to substitut i sensitution a paren de cultures de l'entre-	(A. Pidat (4)))Me is potential desired	-	***************************************
And with the parties of the second section of the second section of the second section	desdelfbrælderet eresteretesbeske.	· auftweifefen saturen auf Labertet, euftrepappen gezoren (beseten	******************************
•	The Commonweal	th of Massachusetts	
Norfolk	n	Jenuary 8,	19 68
Then personally appea	ued the above named Hi	igh Wilson	
and acknowledged the fore	egoing instrument to be	h18 free act and deed, before n	and
•		My communica expires Feb. 15	1974

Recorded Mar. 21, 1968 at 10h.51m.A.M.





355 EAST CENTRAL STREET FRANKLIN, MA 02038-1352 TELEPHONE: 508-520-4907 FAX: 508-520-4906

## MEMORANDUM

**DATE:** March 31, 2021


TO: Franklin Planning Board


FROM: Department of Planning and Community Development

**RE:** Street Acceptance – Brandywine and Charles Drive

1. Attached are final as-builts for Brandywine Drive & Charles Drive from Station 0+00 to Station 2+51.71.

- 2. This roadway and subdivision was approved by the ZBA under Mass Chapter 40B Law.
- 3. The Laws require that the Planning Board recommend all street acceptances to the Town Council prior to the Town Council accepting the roadway.
- 4. The Planning Board should vote on the roadway recommendation.

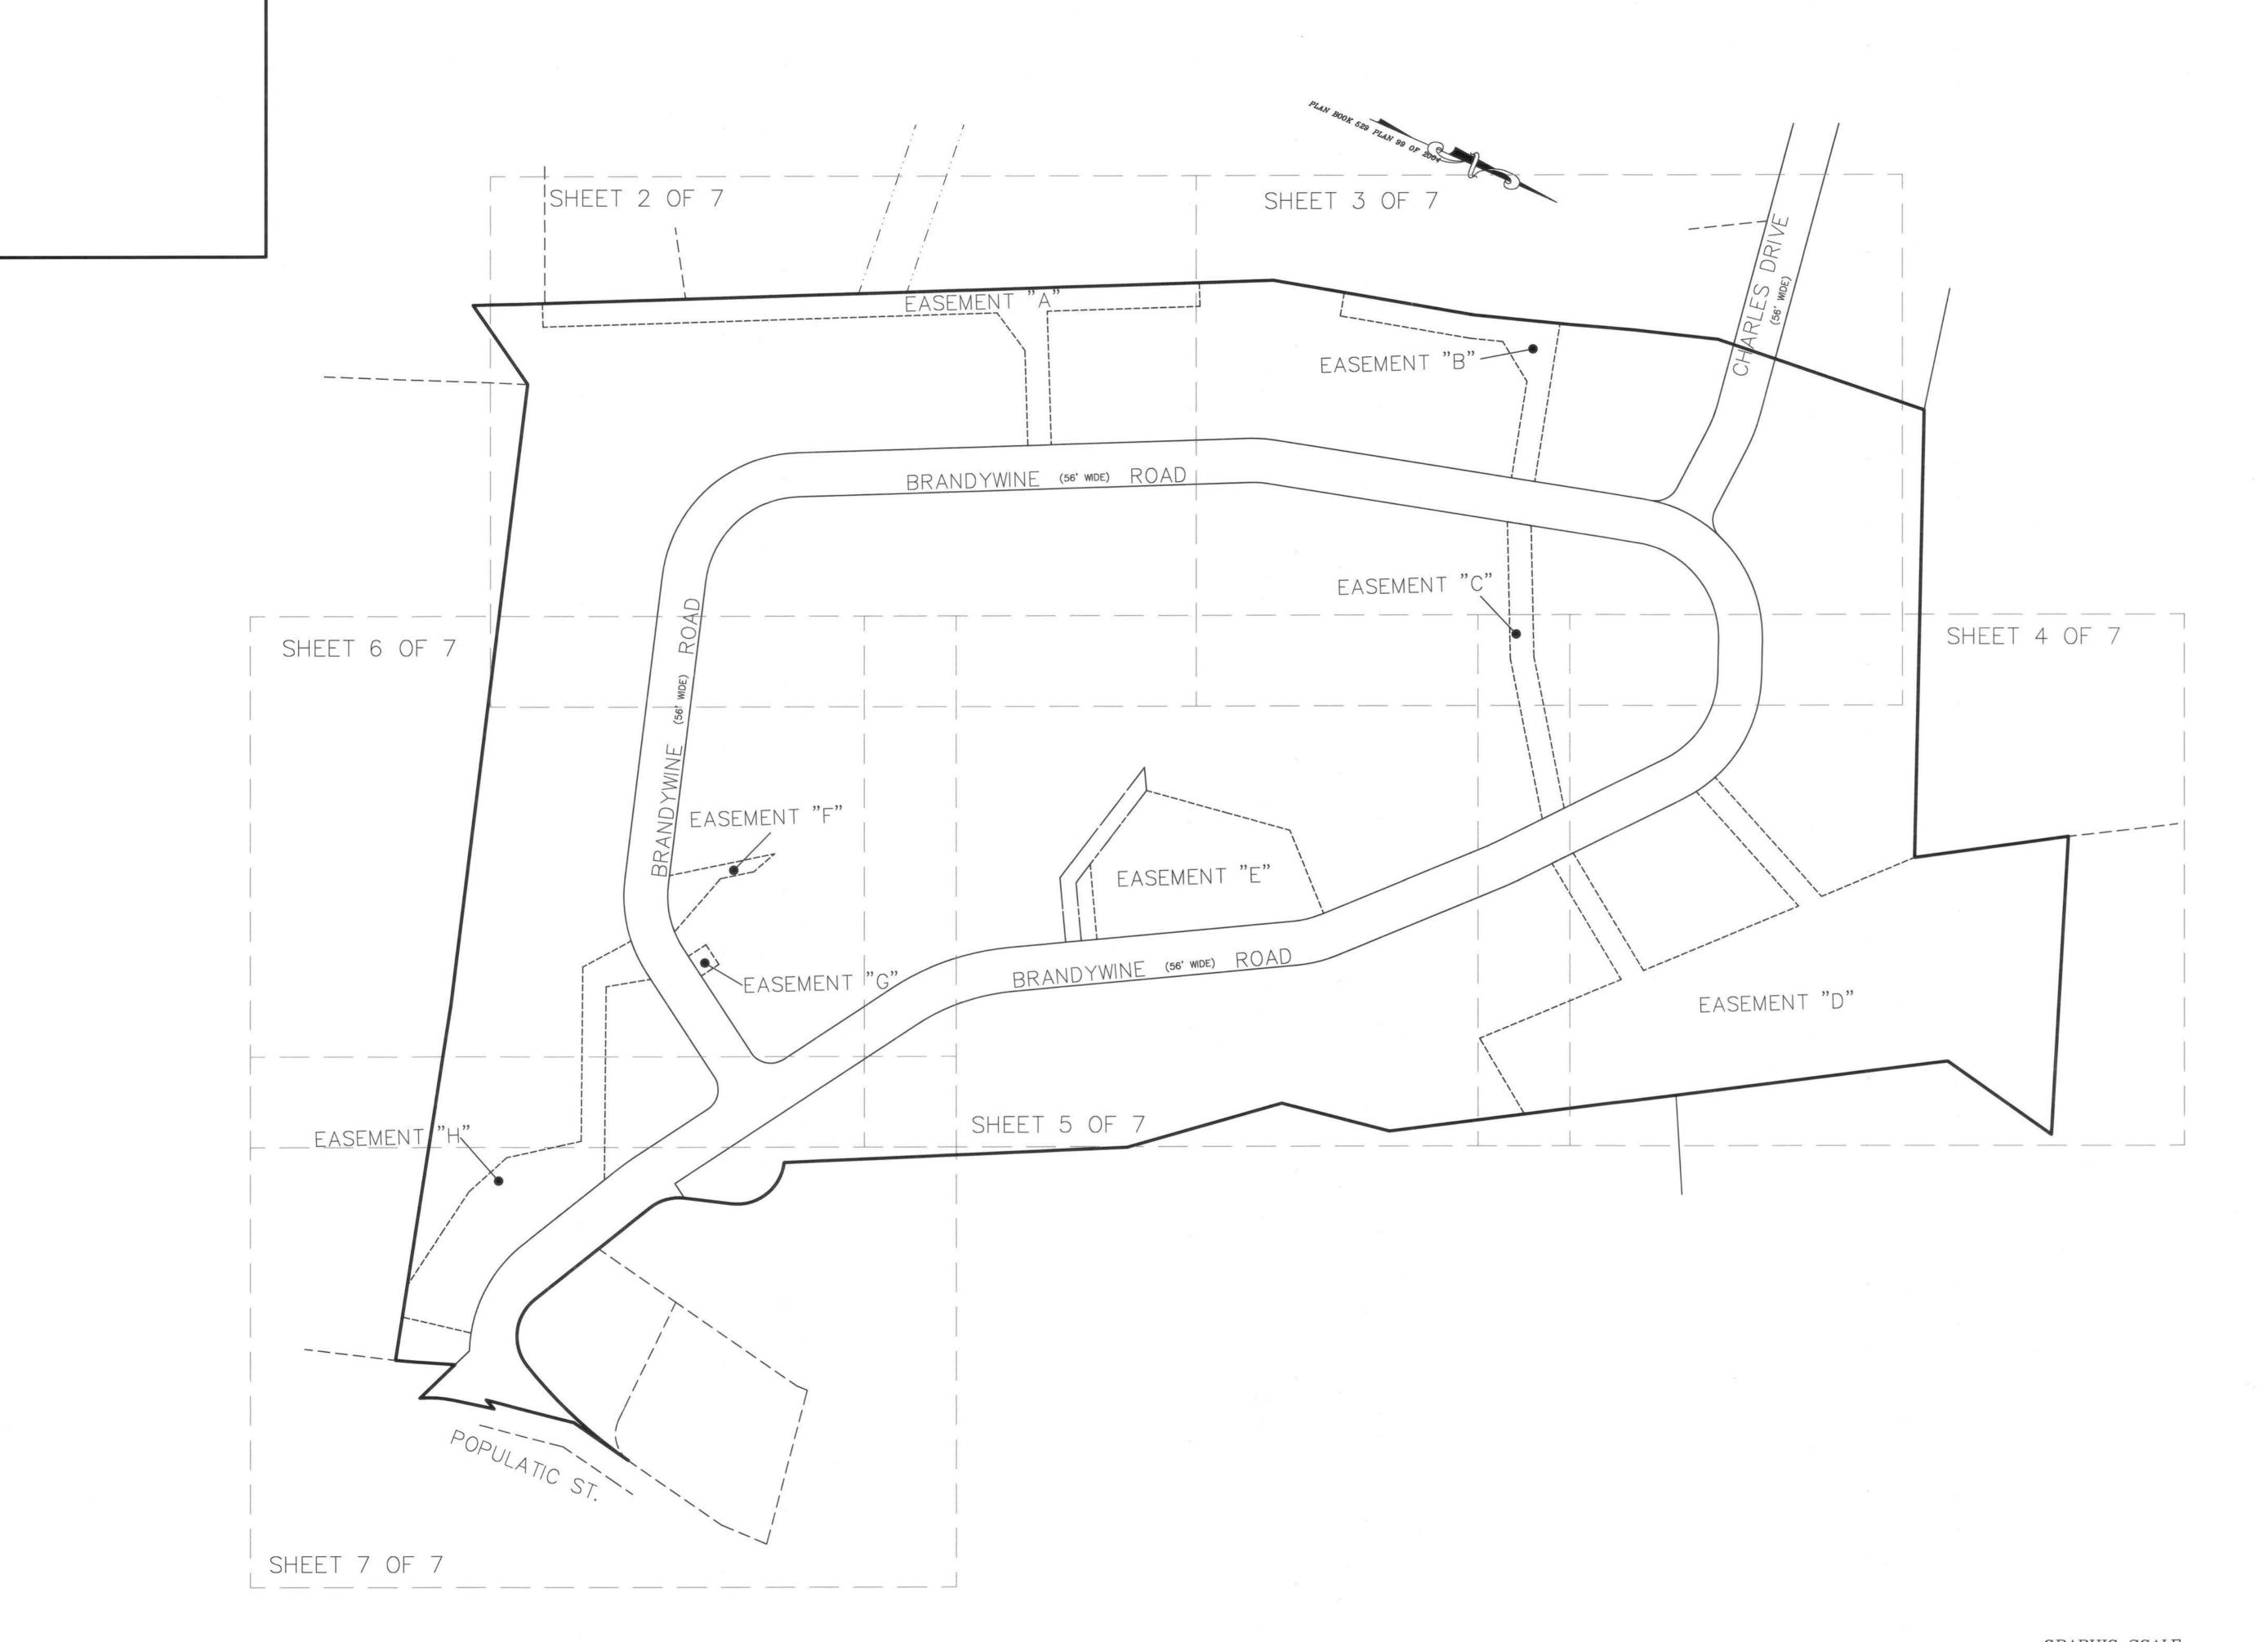

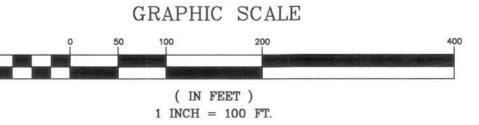

## HIERITAGE DESIGN GROUIP

PLANNERS + SURVEYORS + ENGINEERS LANDSCAPE ARCHITECTS

ONE MAIN STREET

ONE MAIN STREET
WHITINSVILLE, MASSACHUSETTS 01588
TEL 508-266-2066 ~ FAX 508-266-2067
A LIMITED LIABILITY COMPANY

OWNER OF RECORD

MARINELLA DEVELOPMENT, L.L.C.

28 TIA PLACE

FRANKLIN, MA 02038


APPLICANT

MARINELLA DEVELOPMENT, L.L.C.

28 TIA PLACE

FRANKLIN, MA 02038

NOTE:
REFERENCE MADE TO AGREEMENT FOR JUDGMENT, RE:
COMPREHENSIVE PERMIT (G.L. CHAPTER 40B) FOR
BRANDYWINE VILLAGE OFF POPULATIC STREET,
FRANKLIN. RECORDED AT THE NORFOLK COUNTY
REGISTRY OF DEEDS IN BOOK 20979 PAGE 238.

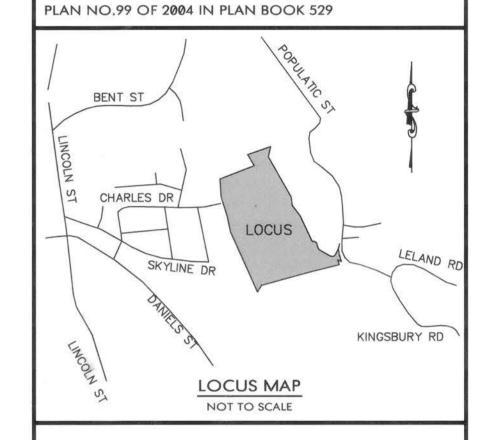

I HEREBY CERTIFY THAT THE PROPERTY LINES SHOWN ON THIS PLAN ARE THE LINES DIVIDING EXISTING OWNERSHIPS, AND THE LINES OF THE STREETS AND WAYS SHOWN ARE THOSE OF PUBLIC OR PRIVATE STREETS OR WAYS ALREADY ESTABLISHED, AND THAT NO NEW LINES FOR DIVISION OF EXISTING OWNERSHIP OR FOR NEW WAYS ARE SHOWN.

THIS PLAN HAS BEEN PREPARED IN CONFORMITY WITH THE RULES AND REGULATIONS OF THE REGISTRARS OF DEEDS IN THE COMMONWEALTH OF MASSACHUSETTS AND IN COMPLIANCE WITH THE RULES AND REGULATIONS FOR THE PRACTICE OF LAND SURVEYING IN THE COMMONWEALTH OF MASSACHUSETTS UNDER SECTION 250 CMR 6.00. THIS CERTIFICATION IS INTENDED TO MEET THE REQUIREMENTS OF THE REGISTERS OF DEEDS AND IS NOT A CERTIFICATION OF THE TITLE OR OWNERSHIP OF THE LAND SHOWN HEREON.



W. ROBERT KNAPIK, PLS NO. 38383

12-12-2016

DATE

# BRANDYWINE VILLAGE, STREET ACCEPTANCE PLAN OF LAND

In The Town Of
Franklin, Massachusetts
Prepared By
Heritage Design Group, LLC
1 Main Street
Whitinsville, MA 01588

SCALE: 1"=30' DATE: OCTOBER 14, 2016
REVISED: NOVEMBER 11, 2016

JOB NUMBER:

2005—178

DRAWING FILE NAME:
2005—178.DWG


DRAWN BY:

TAR


STREET ACCEPTANCE PLAN SHEET 1 OF 7






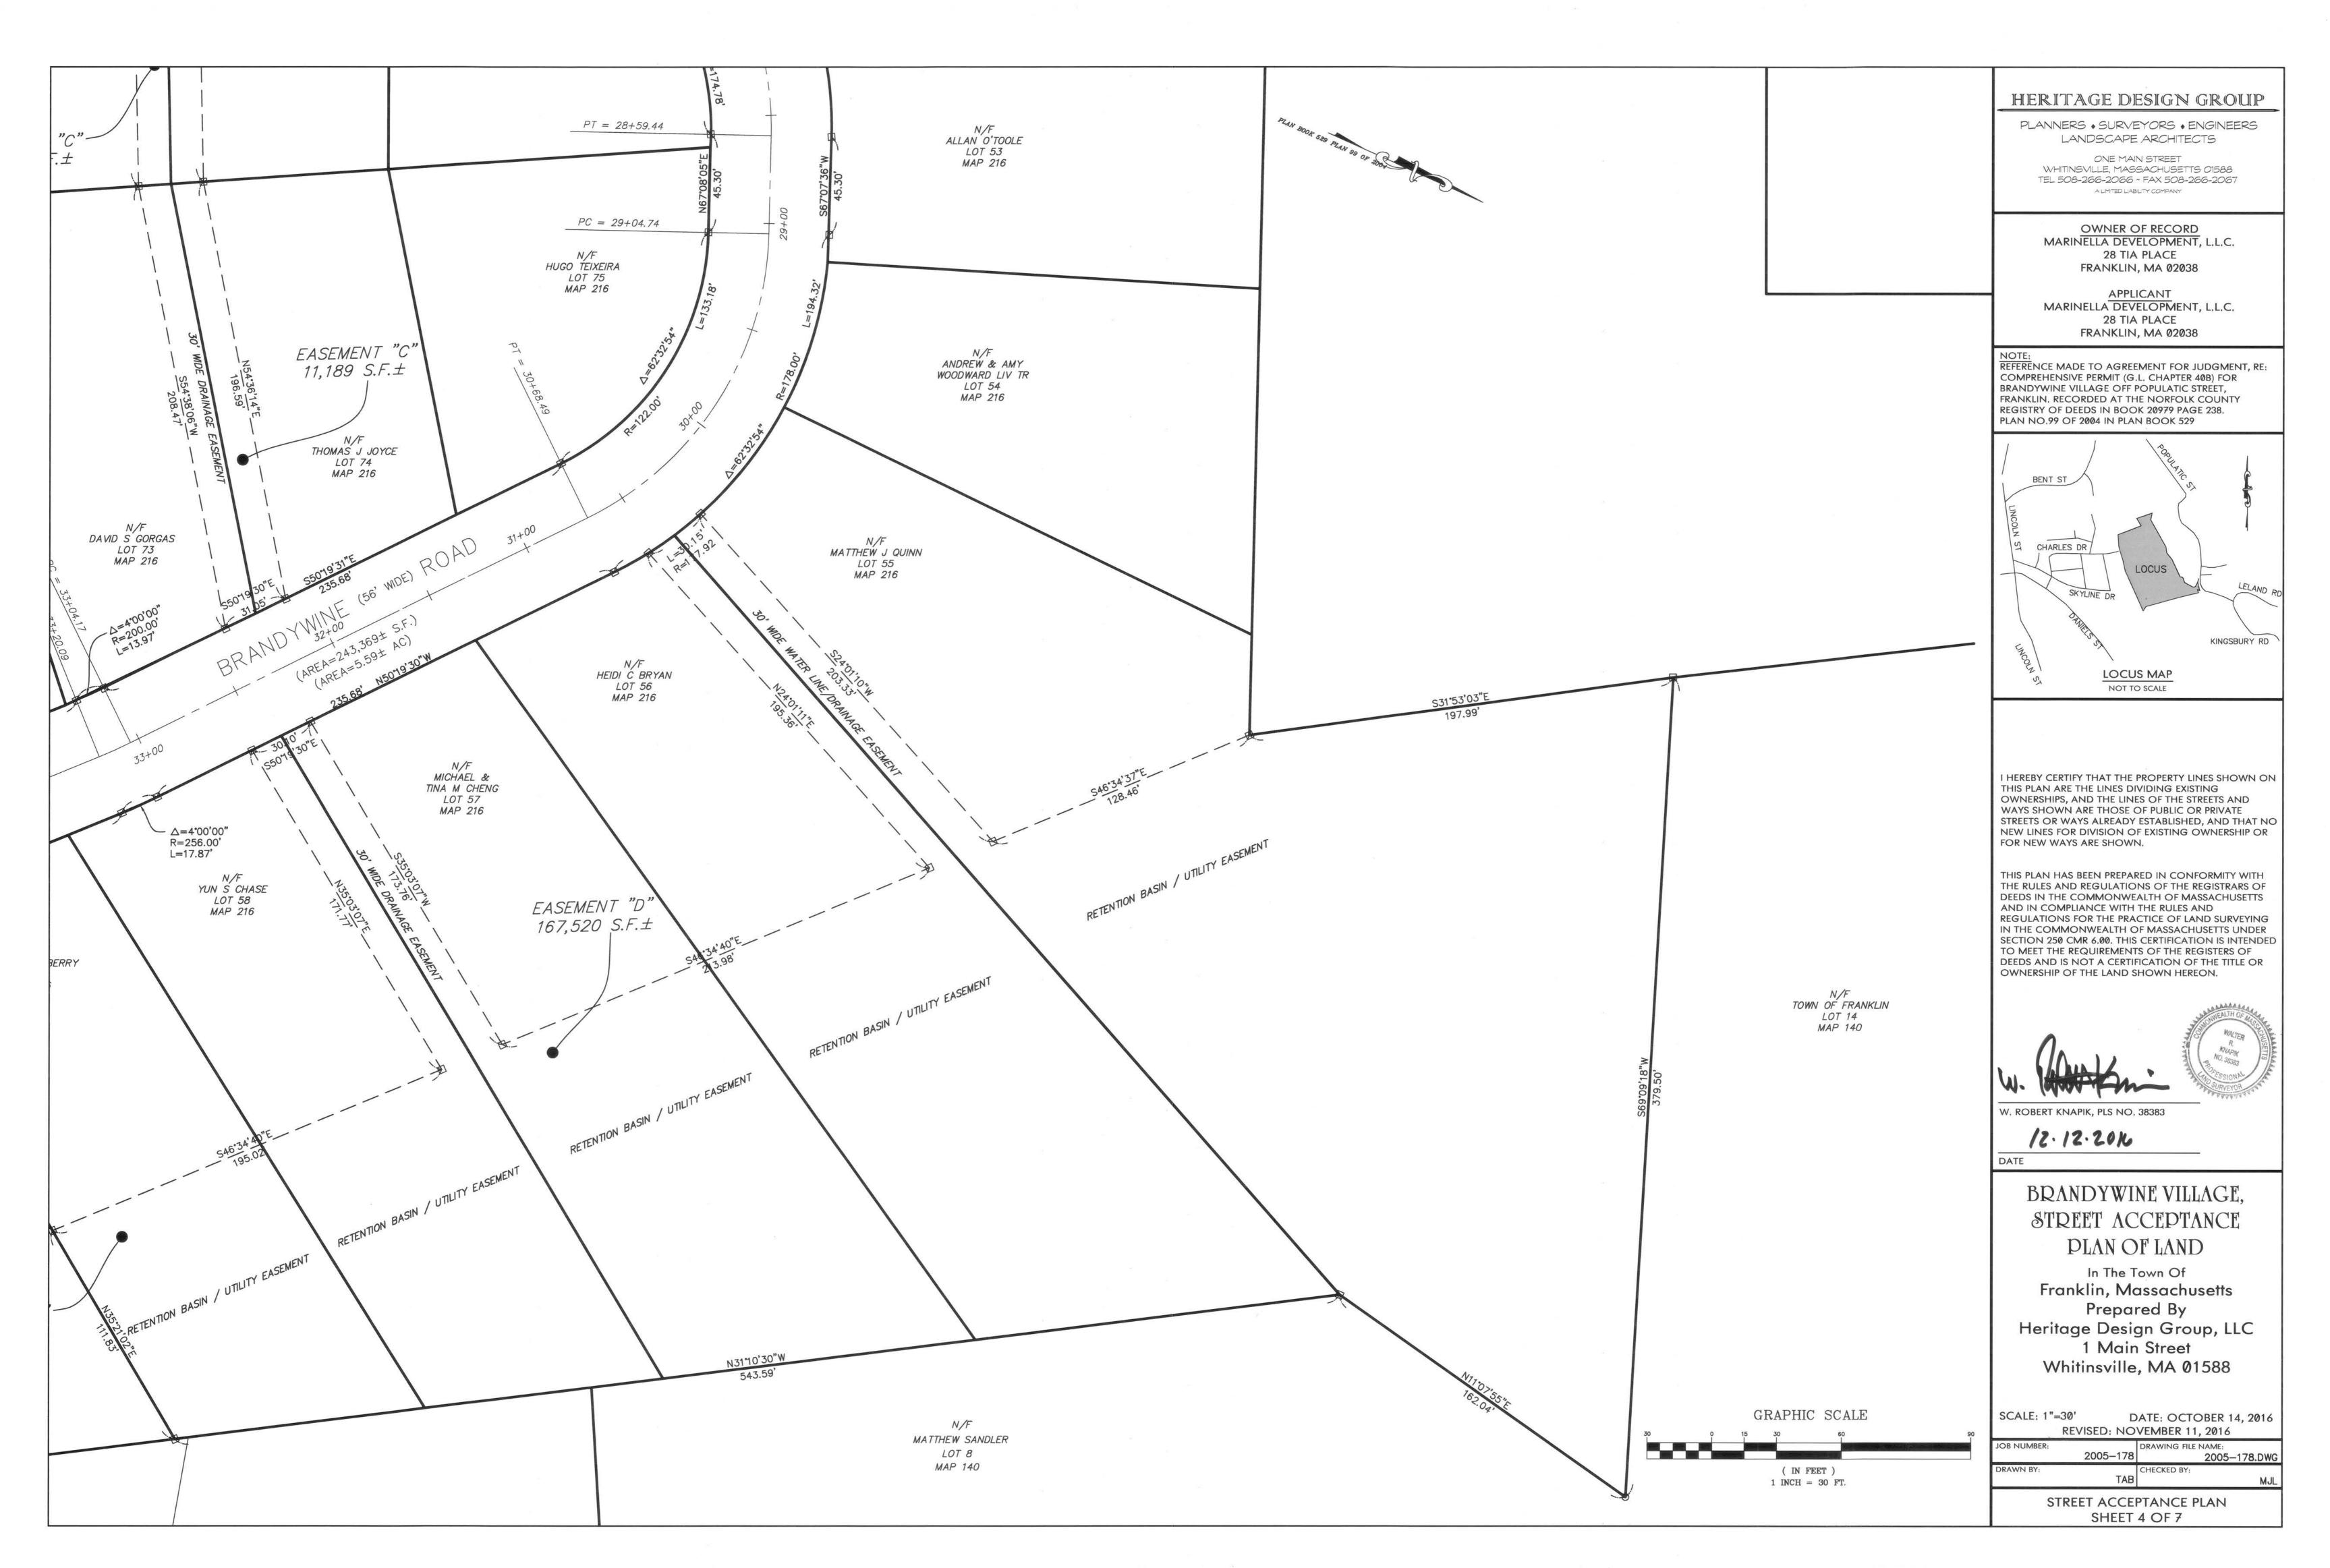



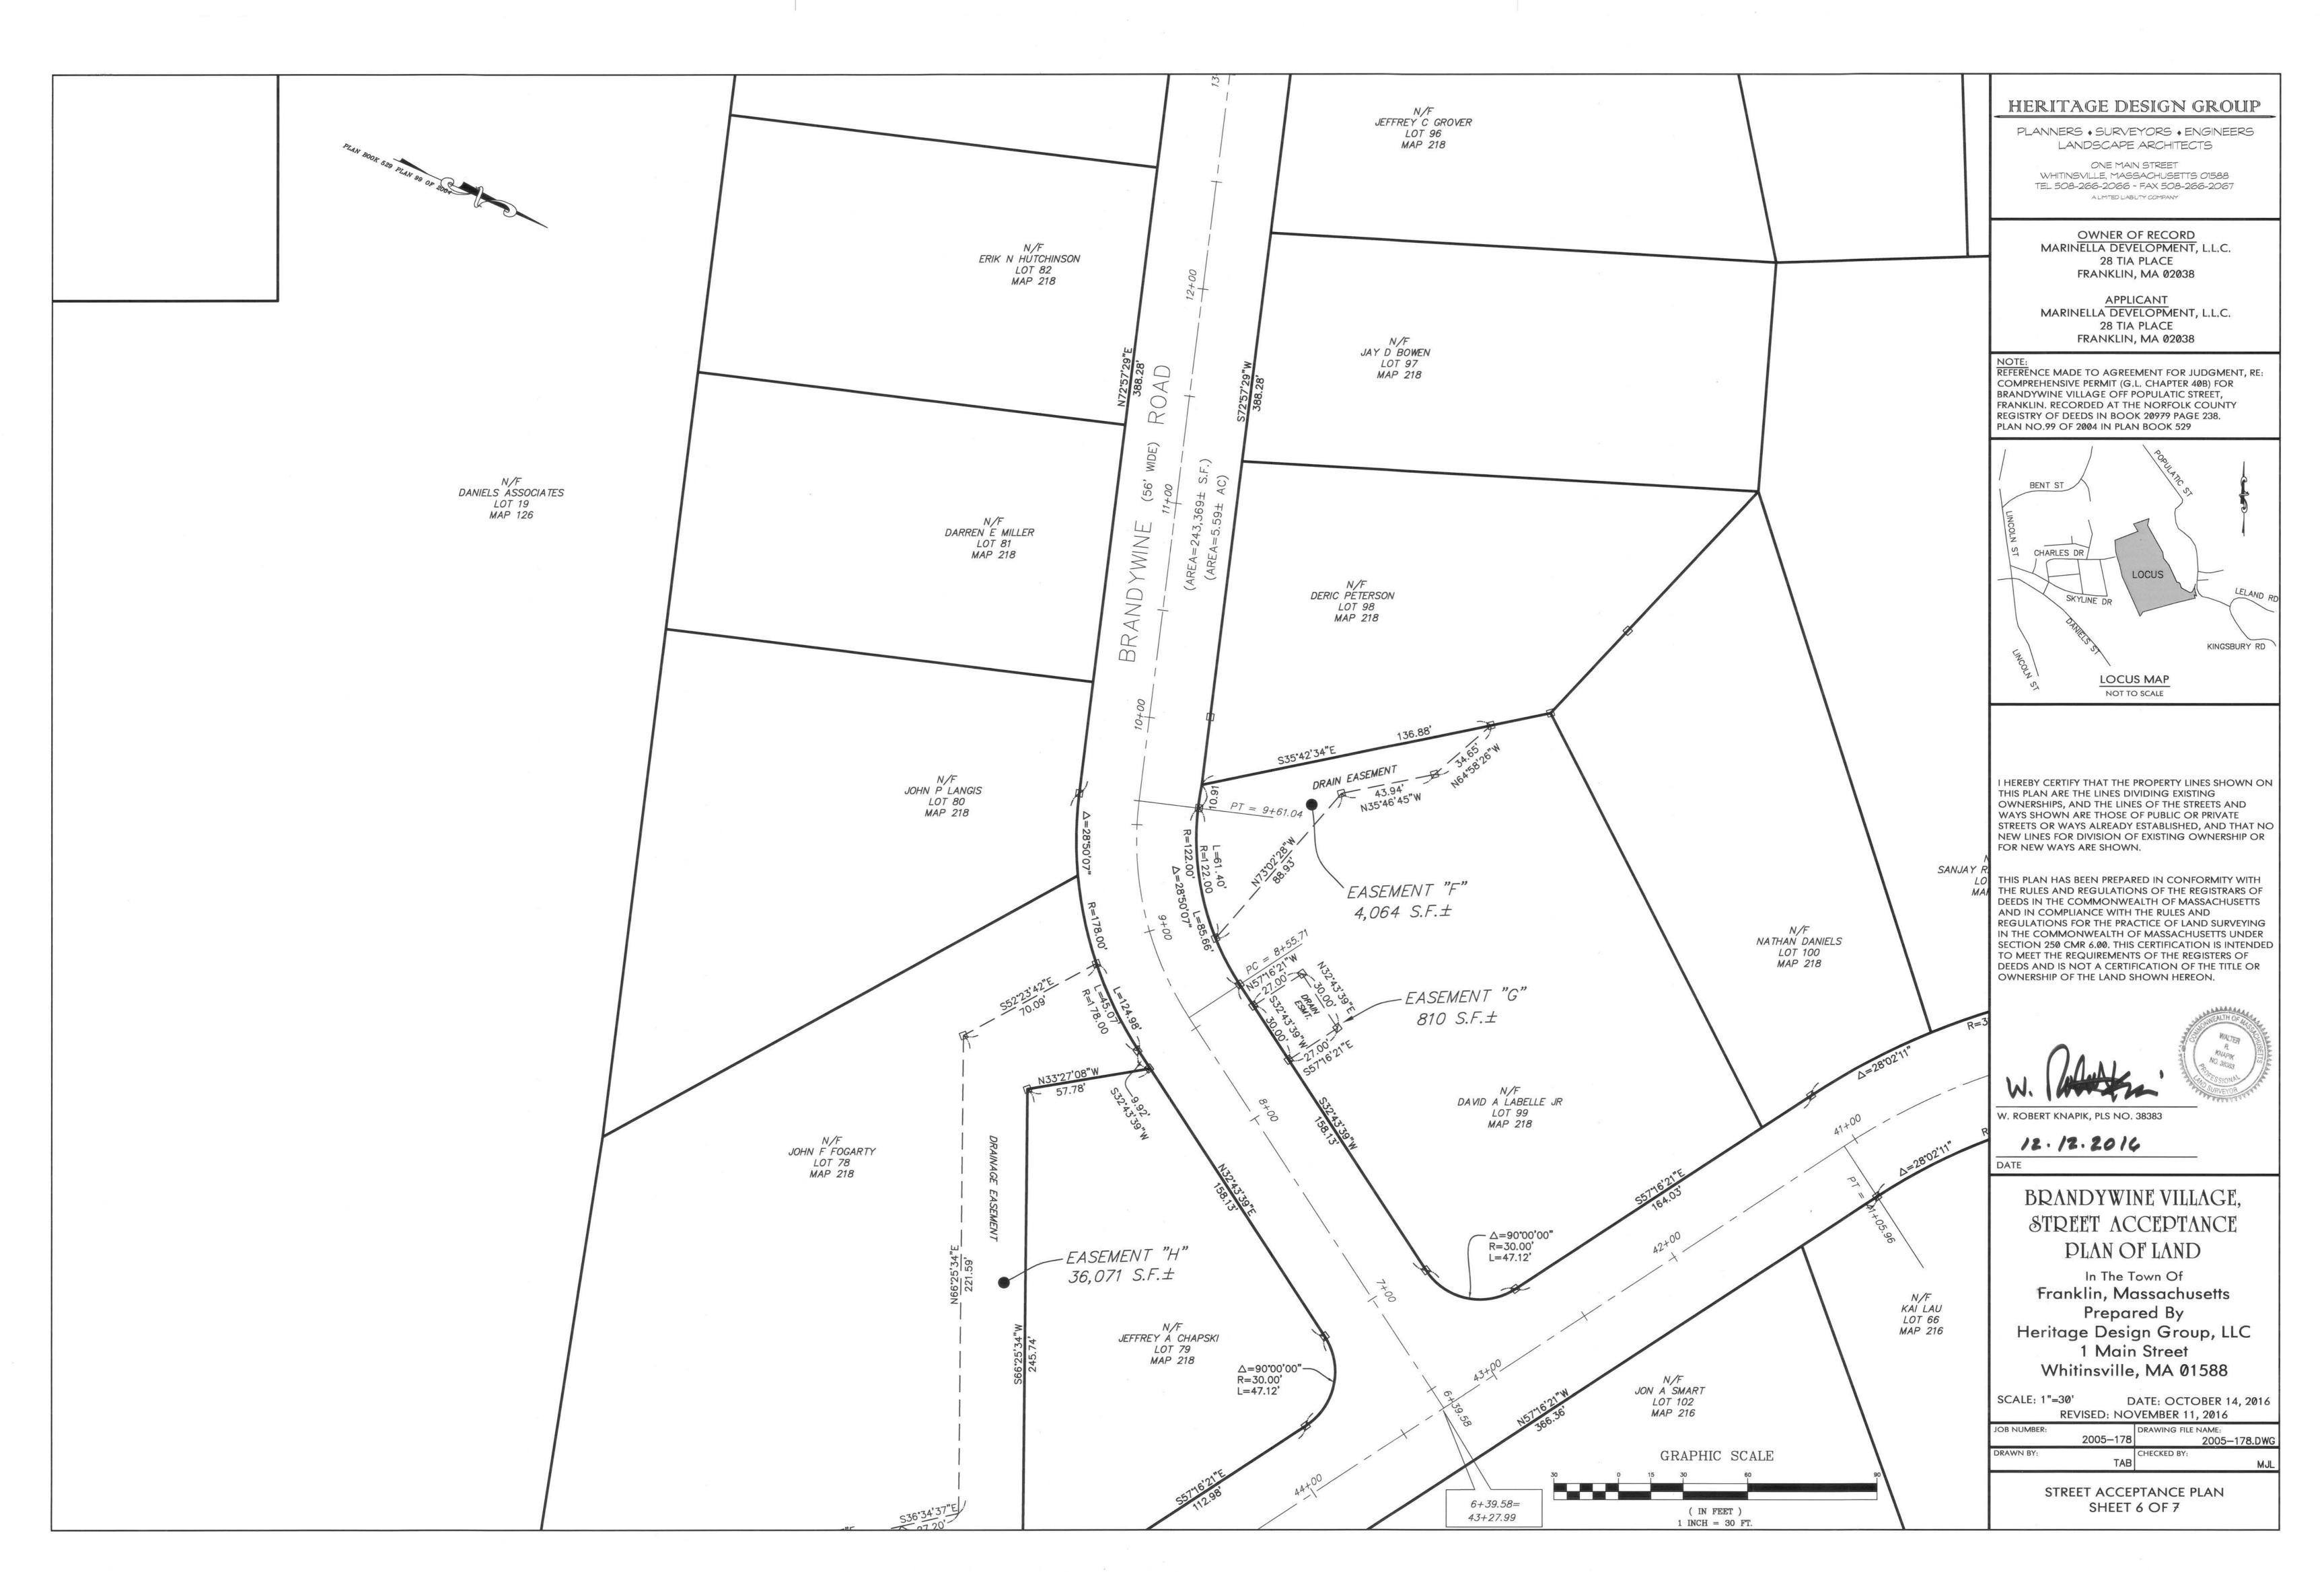

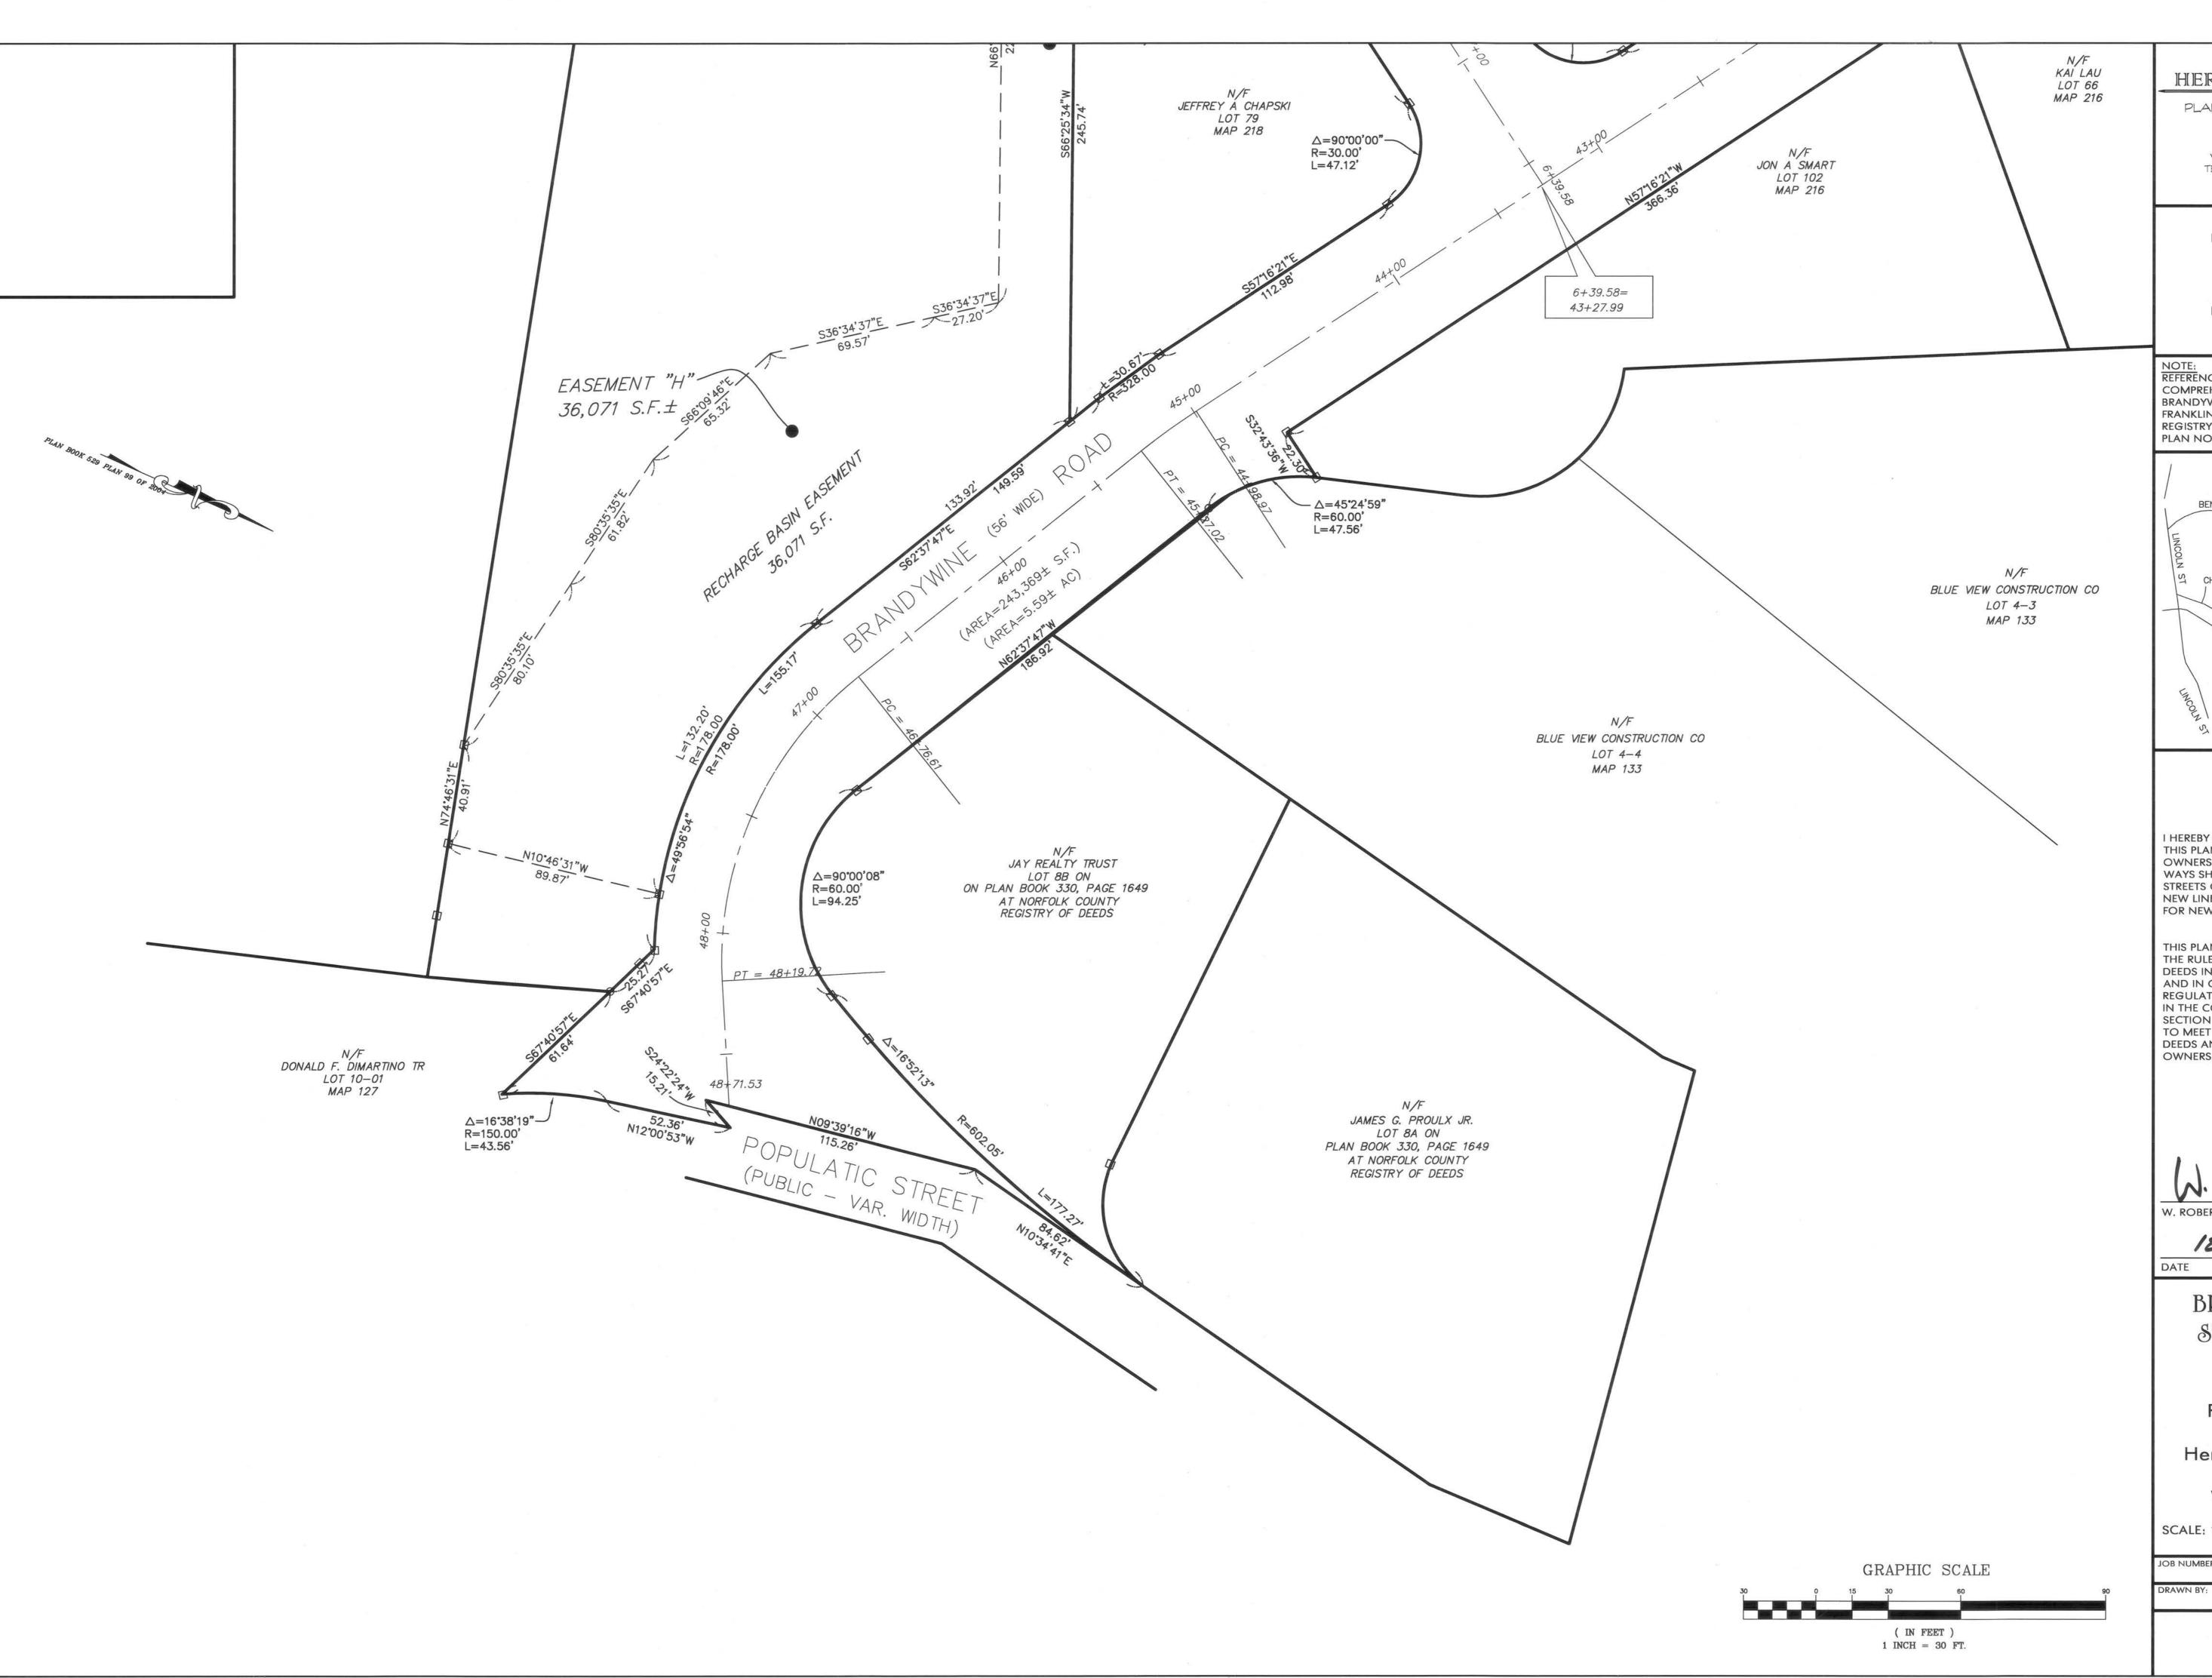

## HIERITAGE DESIGN GROUP


PLANNERS + SURVEYORS + ENGINEERS LANDSCAPE ARCHITECTS

ONE MAIN STREET WHITINSVILLE, MASSACHUSETTS 01588 TEL 508-266-2066 ~ FAX 508-266-2067 A LIMITED LIABILITY COMPANY

OWNER OF RECORD MARINELLA DEVELOPMENT, L.L.C. 28 TIA PLACE FRANKLIN, MA 02038


APPLICANT MARINELLA DEVELOPMENT, L.L.C. 28 TIA PLACE FRANKLIN, MA 02038

NOTE:
REFERENCE MADE TO AGREEMENT FOR JUDGMENT, RE: COMPREHENSIVE PERMIT (G.L. CHAPTER 40B) FOR BRANDYWINE VILLAGE OFF POPULATIC STREET, FRANKLIN. RECORDED AT THE NORFOLK COUNTY REGISTRY OF DEEDS IN BOOK 20979 PAGE 238. PLAN NO.99 OF 2004 IN PLAN BOOK 529

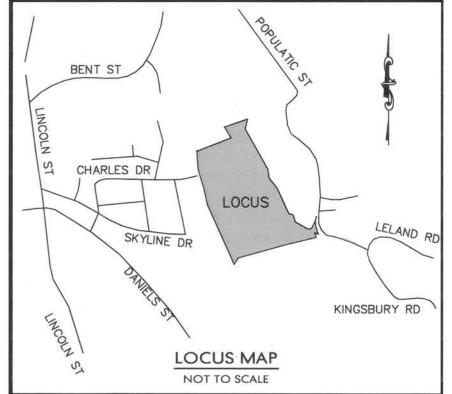

I HEREBY CERTIFY THAT THE PROPERTY LINES SHOWN ON THIS PLAN ARE THE LINES DIVIDING EXISTING OWNERSHIPS, AND THE LINES OF THE STREETS AND WAYS SHOWN ARE THOSE OF PUBLIC OR PRIVATE STREETS OR WAYS ALREADY ESTABLISHED, AND THAT NO NEW LINES FOR DIVISION OF EXISTING OWNERSHIP OR FOR NEW WAYS ARE SHOWN.

THIS PLAN HAS BEEN PREPARED IN CONFORMITY WITH THE RULES AND REGULATIONS OF THE REGISTRARS OF DEEDS IN THE COMMONWEALTH OF MASSACHUSETTS AND IN COMPLIANCE WITH THE RULES AND REGULATIONS FOR THE PRACTICE OF LAND SURVEYING IN THE COMMONWEALTH OF MASSACHUSETTS UNDER SECTION 250 CMR 6.00. THIS CERTIFICATION IS INTENDED TO MEET THE REQUIREMENTS OF THE REGISTERS OF DEEDS AND IS NOT A CERTIFICATION OF THE TITLE OR OWNERSHIP OF THE LAND SHOWN HEREON.

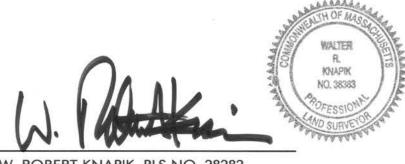

12.12.2016

## BRANDYWINE VILLAGE, STREET ACCEPTANCE PLAN OF LAND

In The Town Of Franklin, Massachusetts Prepared By Heritage Design Group, LLC 1 Main Street Whitinsville, MA 01588

SCALE: 1"=30' DATE: OCTOBER 14, 2016 REVISED: NOVEMBER 11, 2016

JOB NUMBER: 2005-178 2005-178.DWG TAB CHECKED BY:

> STREET ACCEPTANCE PLAN SHEET 7 OF 7





355 EAST CENTRAL STREET FRANKLIN, MA 02038-1352 TELEPHONE: 508-520-4907

Fax: 508-520-4906

#### **MEMORANDUM**

March 31, 2021 **DATE:** 

TO: Franklin Planning Board

**Department of Planning and Community Development** FROM:

**Countryside Estates** RE:

> The attached email was received via email by a resident's Attorney on Countryside Estates. Amy forwarded the email to all members of the Planning Board.

Chairman Padula asked that this be discussed at tonight's meeting.



## Walsh / 10 Countryside Lane

1 message

Michael Robbins <mrobbins@crowleycummings.com>

Wed, Mar 17, 2021 at 2:04 PM

To: "alove@franklinma.gov" <alove@franklinma.gov>, "apadula@franklinma.gov" <apadula@franklinma.gov>, "jhalligan@franklinma.gov, "wdavid@franklinma.gov" <wdavid@franklinma.gov>, "wdavid@franklinma.gov" <wdavid@franklinma.gov>, "rpower@franklinma.gov" <room <cre>cyrondeau@franklinma.gov, "grondeau@franklinma.gov, "grondeau@franklinma.gov, "jwilliams@franklinma.gov, "jwilliams.gov, "jwilliams.gov, "jwilliams.gov, "jwilliams.gov, "jwilliams.gov, "jwill

Dear Planning Board and Town Planner:

I represent Beth and Chris Walsh with regard to their real property located at Countryside Lane.

The issue is that the Seller / Developer Joel D'errico had not installed the sidewalks per the approved site plan prior to the issuance of the certificate of occupancy over **seven** years ago.

It is our understanding that the Developer is now being requiring by the Town to install these sidewalks **seven** years after the sale of the lot to my clients and the other abutting property owners.

In that time the Walshes have installed their driveway, sprinkler systems, stonewalls, hardscapes, planted trees and landscaping all of which will now be disturbed and altered by the installation of these sidewalks.

The Walshes feel strongly that the Developer will install the sidewalk as per the plan and then leave the landowners bearing the costs to the damage to their property.

The Walshes are requesting that either the town to forgo the sidewalk installation or have the town ensure that any and all landscape / hardscape / driveway disturbed areas are professionally restored by the Developer and not release any bond until such work is professionally completed.

We look forward to your attention to this matter.



Crowley & Cummings, LLC

980 Washington St., Suite 123

Dedham, MA 02026

Main office: 781-251-0540

Fax: 781-251-0541

Direct: 508-960-3330

Cell: 508-725-3797

mrobbins@crowleycummings.com

www.mrobbinslaw.com

Licensed in Massachusetts, Rhode Island, Florida & Connecticut

**WESTBOROUGH OFFICE - 45 LYMAN STREET** 

**SOUTH END OFFICE- 538 TREMONT STREET** 

\*\* Offices also in Boston, Hyannis & Needham

#### FRAUD ALERT:

NEVER rely on any emails asking you to wire money to any account, including emails that may appear to come from my office. If you receive any instructions to send a wire, BE SURE to call our office at 781-251-0540 to confirm all wire instructions.

- -This e-mail message is confidential and is intended only for the named recipient(s). It may contain information that is subject to the attorney client privilege or the attorney work-product doctrine or that is otherwise exempt from disclosure under applicable law. If you have received this e-mail message in error, or are not the named recipient(s), please immediately notify the sender and delete this message from your computer and destroy all copies.
- -To comply with IRS regulations, we advise that any discussion of Federal tax issues in this e-mail is not intended or written to be used, and cannot be used, (i) to avoid any penalties imposed under the Internal Revenue Code or (ii) to promote, market or recommend to another party any transaction or matter addressed herein.
- -E-mails sent or received shall neither constitute acceptance of conducting transactions via electronic means nor shall create a binding contract in the absence of a fully signed written agreement.

Crowley & Cummings, LLC has earned the Secure Settlements "Trusted and Verified" seal as part of our ongoing commitment to meet and exceed federal regulatory requirements and to maintain the highest professional standards in the industry.





355 EAST CENTRAL STREET FRANKLIN, MA 02038-1352 TELEPHONE: 508-520-4907

Fax: 508-520-4906

## **MEMORANDUM**

**DATE:** March 31, 2021

**TO:** Franklin Planning Board

FROM: Department of Planning and Community Development

**RE:** Public Hearings for April 5, 2021

The following is the status of the public hearings for tonight:

- 1. 27 Forge Parkway requested to be continued to May 10
- 2. Olam Estates applicant will be requesting to be continued to a later date and will be providing an extension on the decision timeframe.
- 3. 515 West central St No new information has been submitted.