


S:\DPW\_Engineering\Projects\Beaver St\Chilson Park Playground Expansion\Plns\CAD\2020 Park Expansion - Chilson Park.dwg Jun 29, 2022, 8:10am

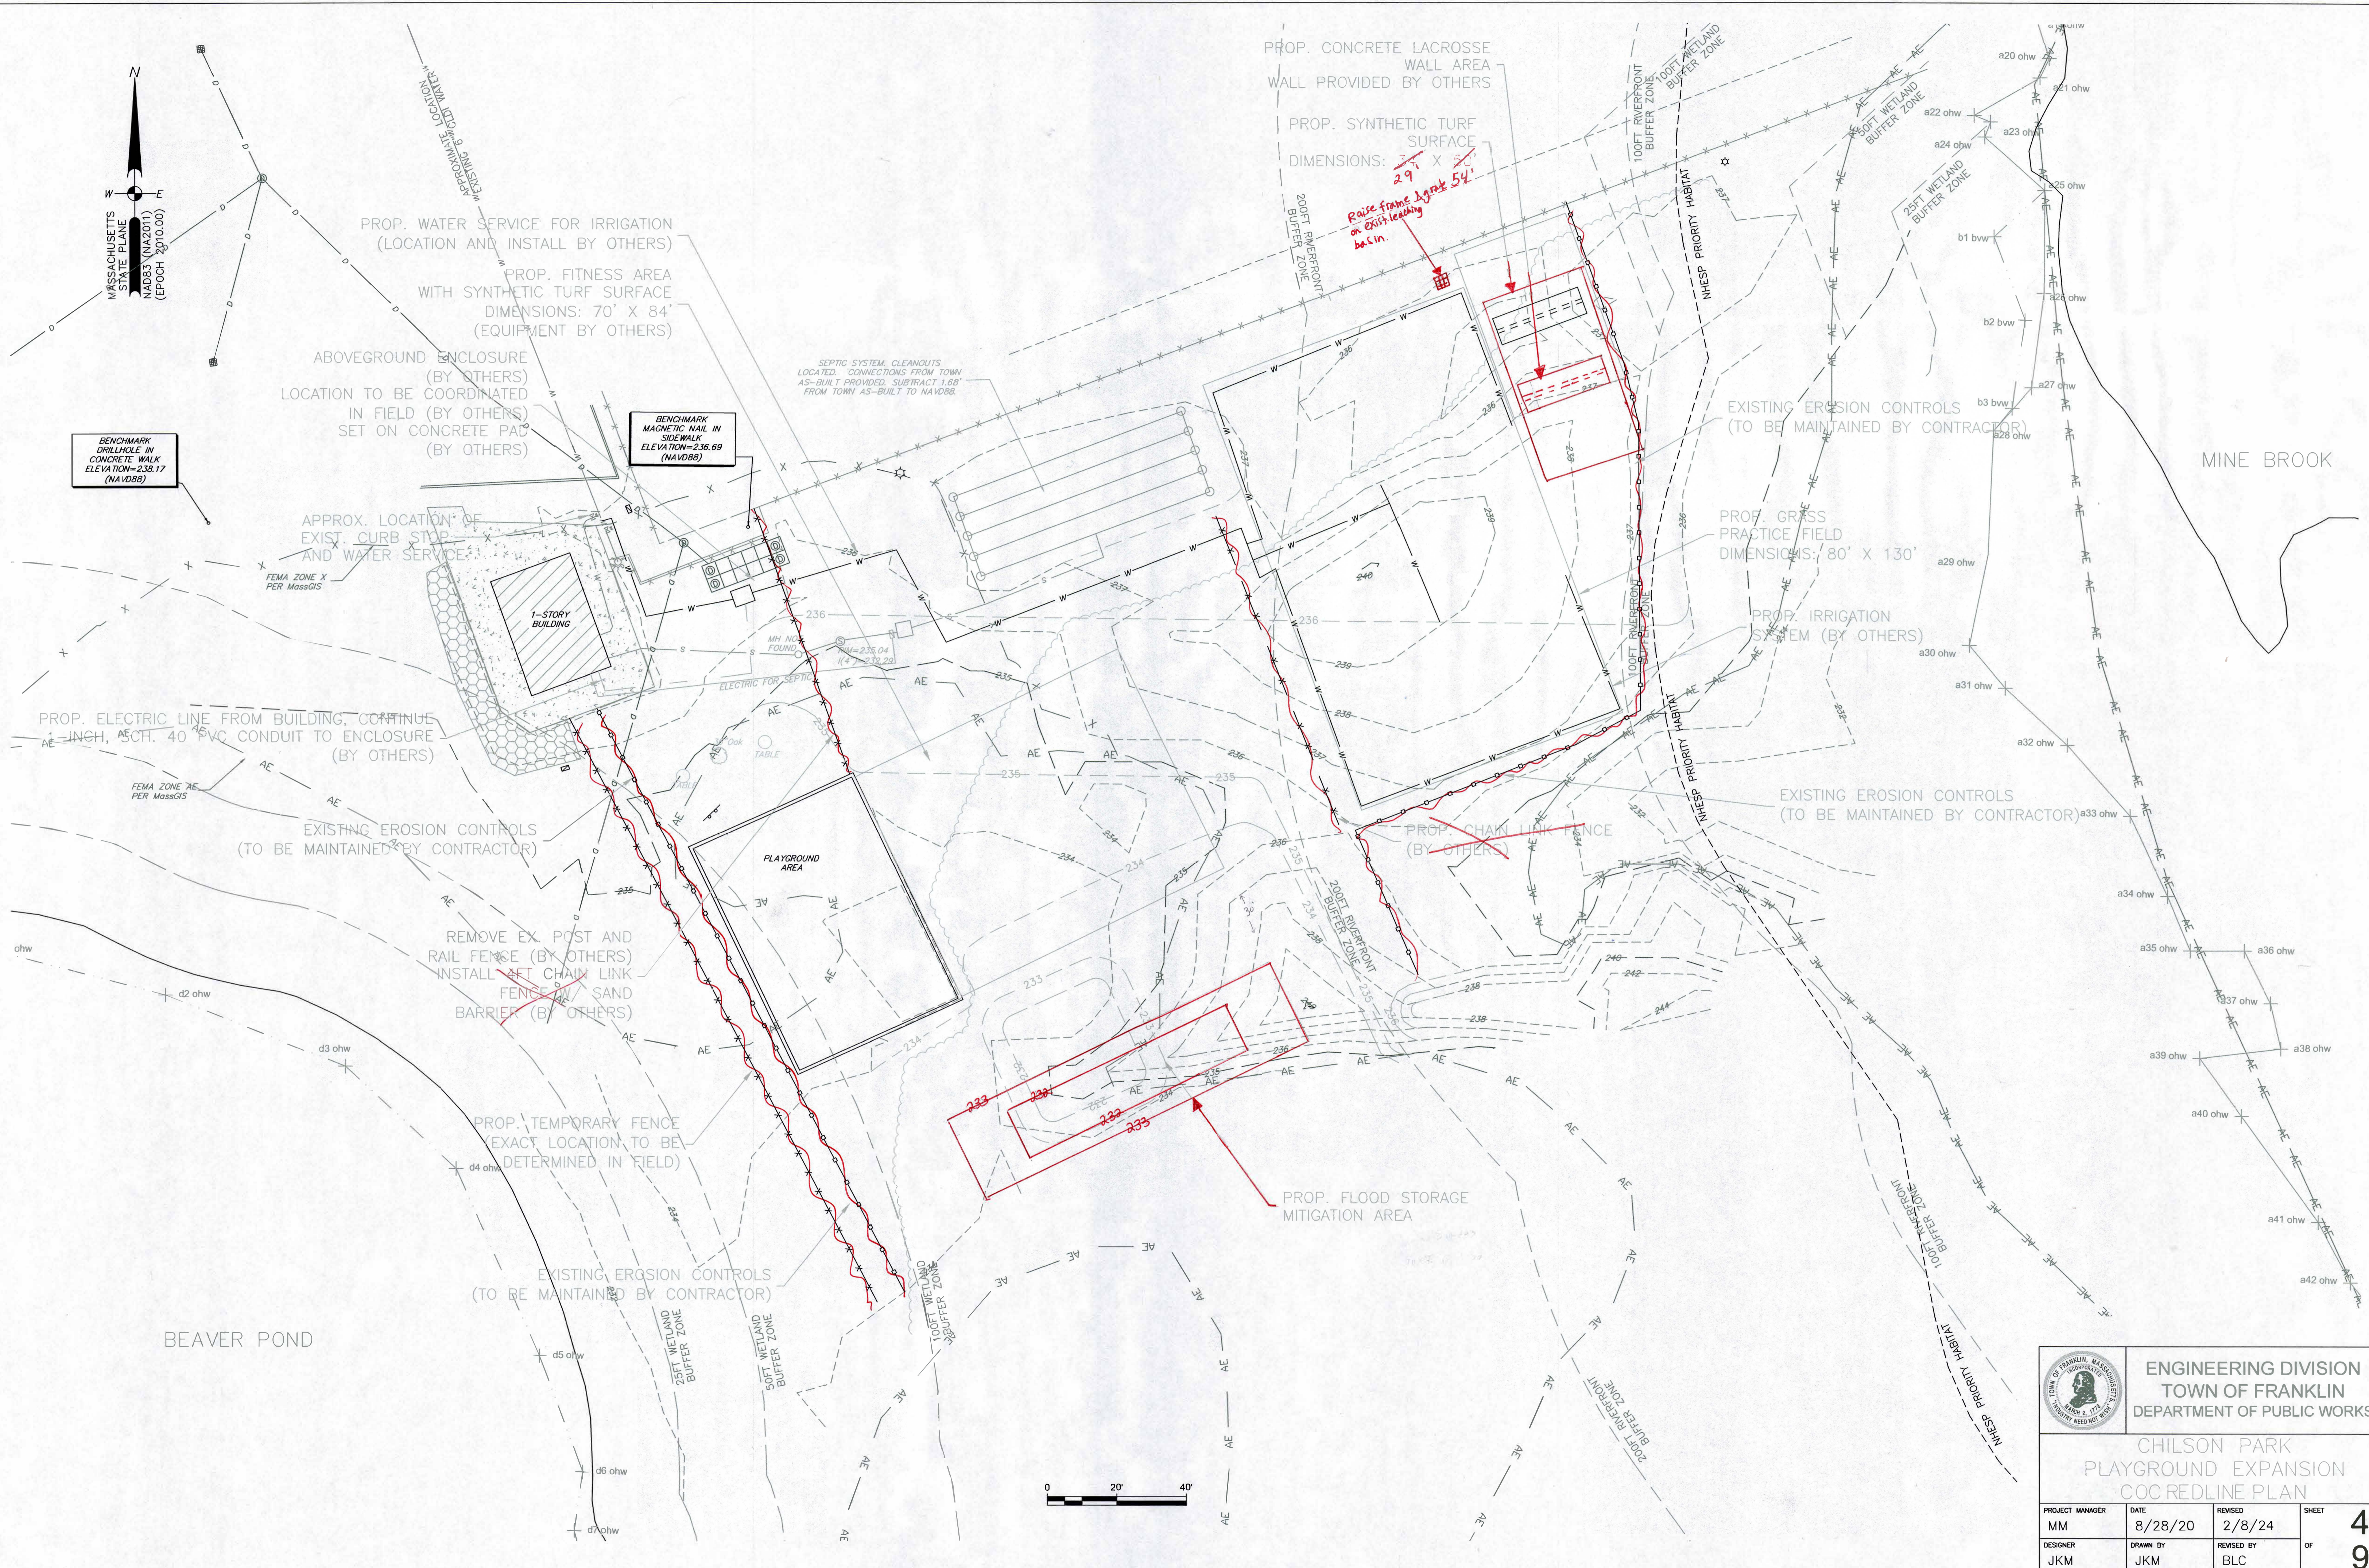

BENCHMARK  
DRILLHOLE IN  
CONCRETE WALK  
ELEVATION=238.17  
(NAVD88)

BENCHMARK  
MAGNETIC NAIL IN  
SIDEWALK  
ELEVATION=236.69  
(NAVD88)

29' X 54'  
Raise frame height  
on existing  
basin.

		ENGINEERING DIVISION TOWN OF FRANKLIN DEPARTMENT OF PUBLIC WORKS	
CHILSON PARK PLAYGROUND EXPANSION COC REDLINE PLAN			
PROJECT MANAGER MM	DATE 8/28/20	REVISED 2/8/24	SHEET 4
DESIGNER JKM	DRAWN BY JKM	REVISED BY BLC	OF 9