

# Town of Franklin

355 East Central Street  
Franklin, Massachusetts 02038-1352



Phone: (508) 520-4907  
www.franklinma.gov

## DEPARTMENT OF PLANNING AND COMMUNITY DEVELOPMENT

### MEMORANDUM

**DATE:** September 20, 2023  
**TO:** Franklin Planning Board  
**FROM:** Department of Planning and Community Development  
**RE:** Road Acceptance – Farrington St




---

#### **General:**

1. The Town has put together as-built plans to accept the roadways listed above.
2. The vote to accept the roadways is a recommendation to Town Council.

#### **Recommendation:**


DPCD recommends that the Board vote to recommend to Town Council.

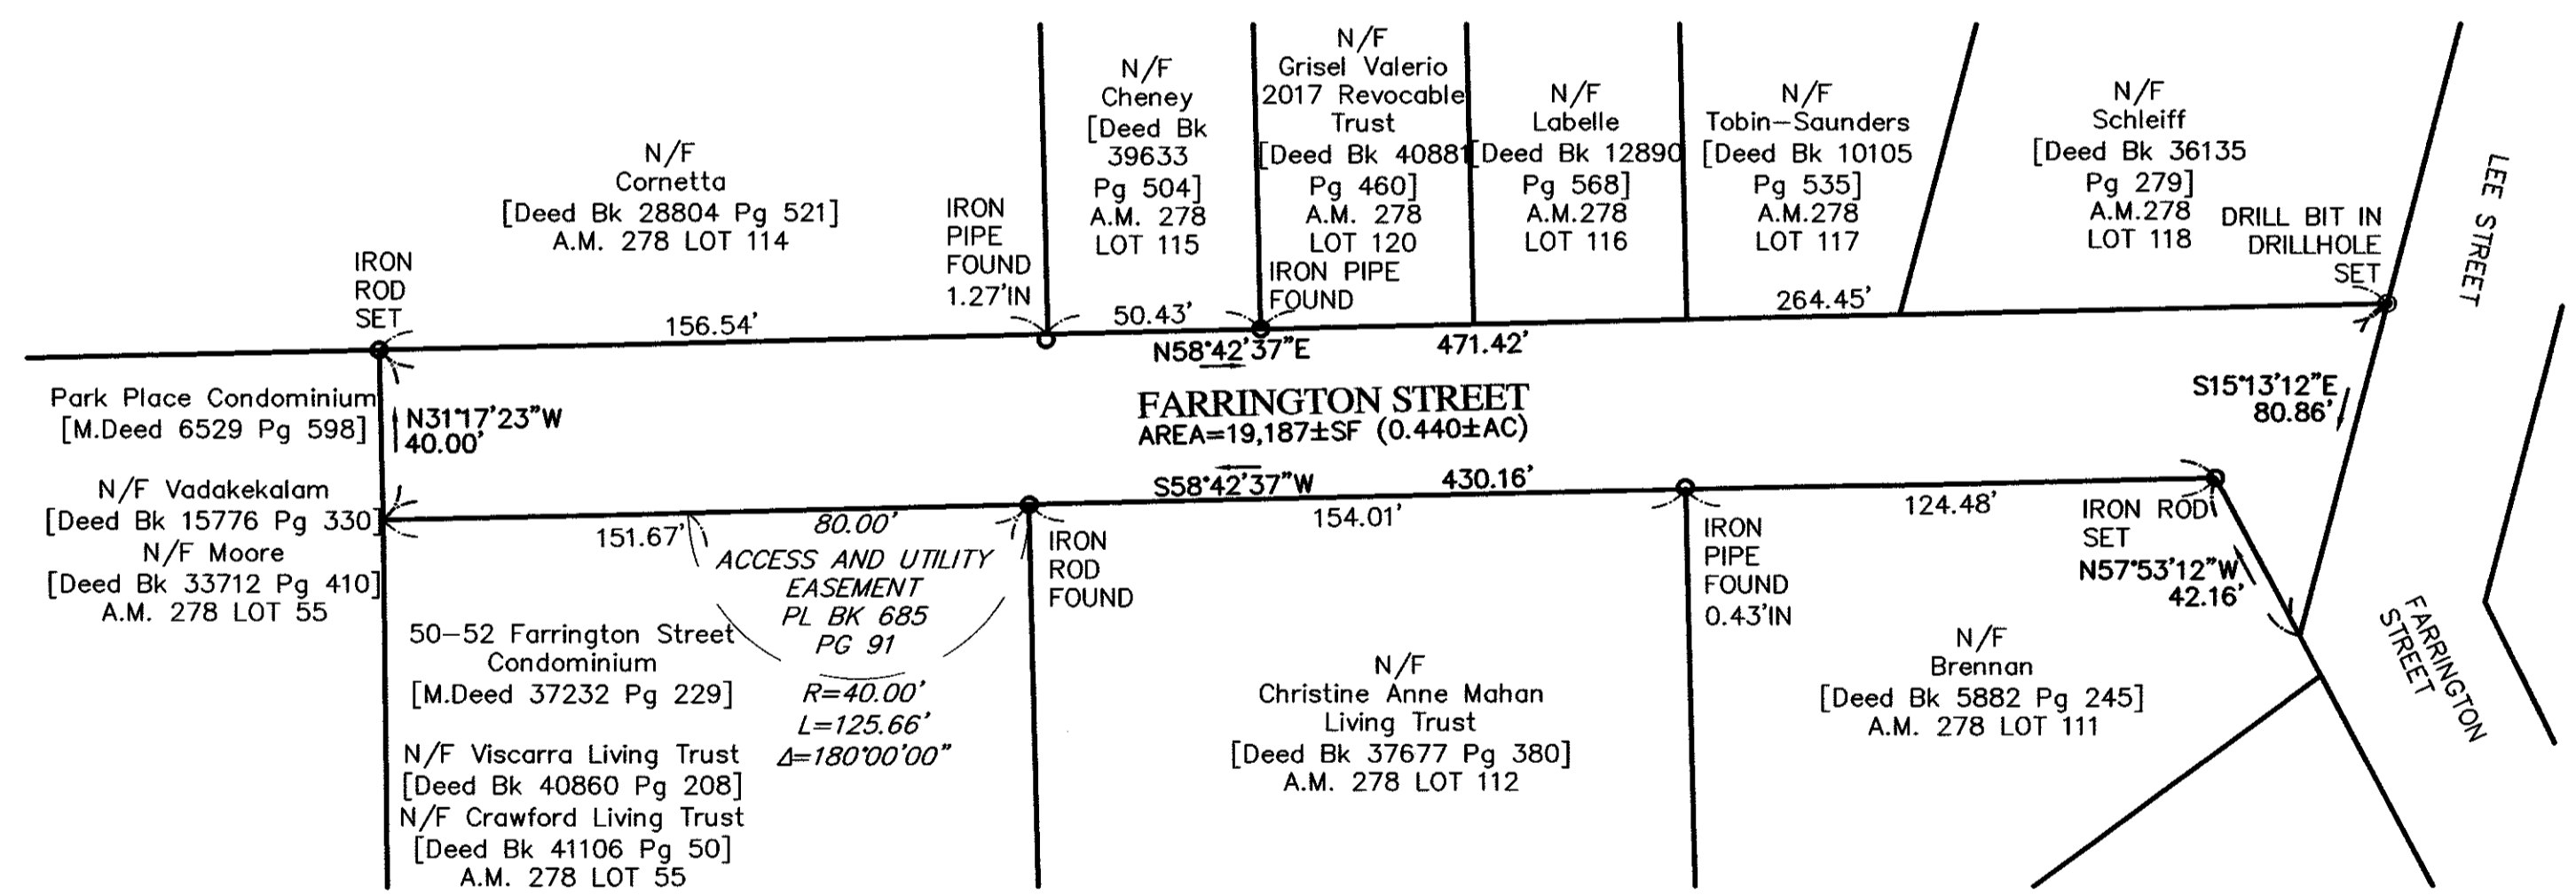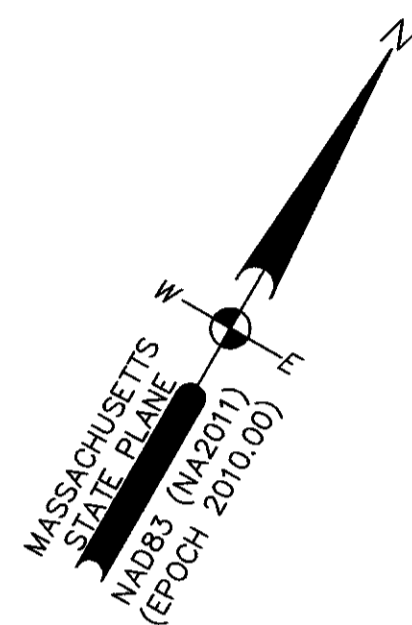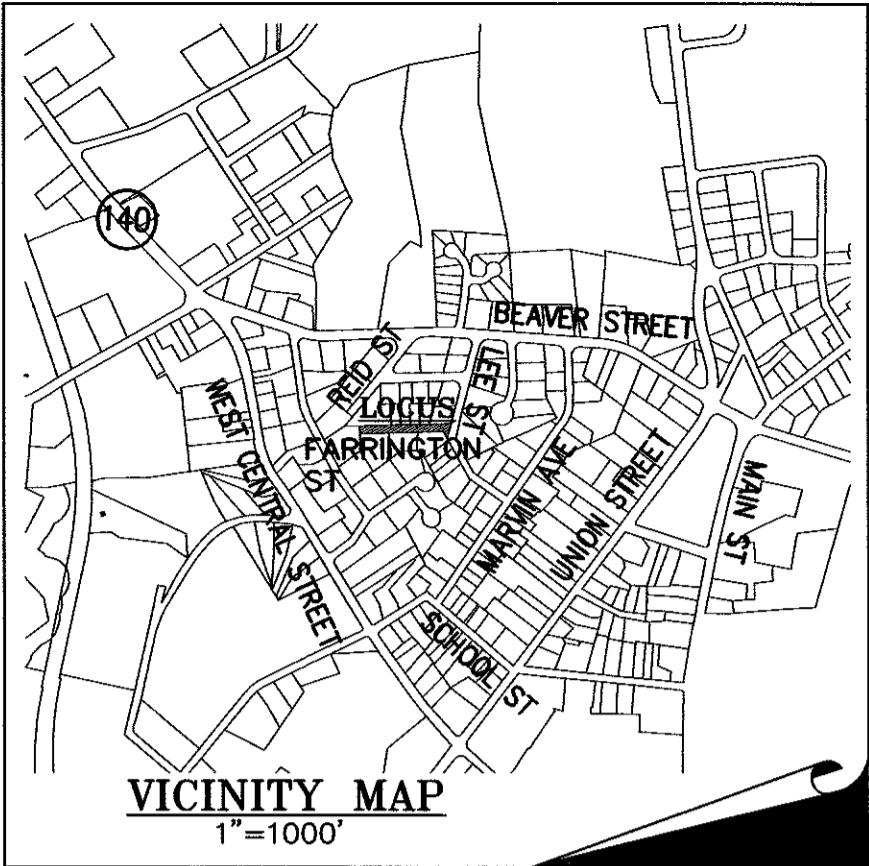

I HEREBY CERTIFY THAT THE PROPERTY LINES SHOWN ON THIS PLAN ARE THE LINES DIVIDING EXISTING OWNERSHIPS AND THE LINES OF THE STREETS AND WAYS SHOWN ARE THOSE OF PUBLIC OR PRIVATE STREETS OR WAYS ALREADY ESTABLISHED AND THAT NO NEW LINES FOR DIVISION OF EXISTING OWNERSHIP OR FOR NEW WAYS ARE SHOWN.

I CERTIFY THAT THIS PLAN HAS BEEN PREPARED IN ACCORDANCE WITH THE RULES AND REGULATIONS OF THE REGISTER OF DEEDS.

THIS IS NOT A CERTIFICATION AS TO THE TITLE OR OWNERSHIP OF THE LAND SHOWN HEREON.

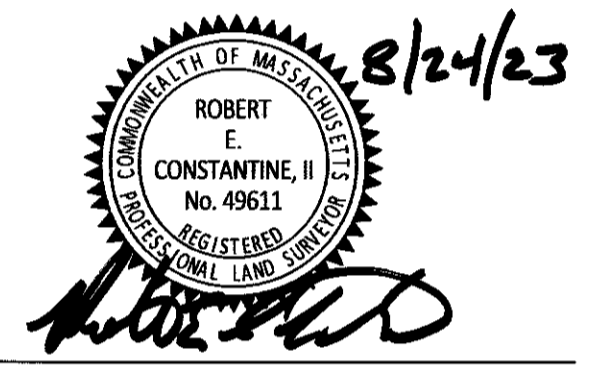


SEE PLAN FILED AS No. 3570 PL. BK. 74

**STREET LAYOUT, ACCEPTANCE, AND TAKING PLAN FOR A PORTION OF FARRINGTON STREET FRANKLIN, MASSACHUSETTS**

**AUGUST 24, 2023**

DATE	REVISION DESCRIPTION

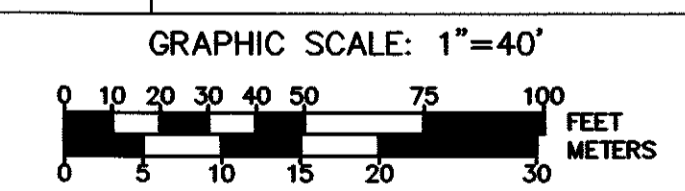

**Guerriere & Halnon, Inc.**  
ENGINEERING & LAND SURVEYING  
55 WEST CENTRAL ST. PH. (508) 528-3221  
FRANKLIN, MA 02038 FX. (508) 528-7921  
www.gandhengineering.com

K:\F4397.dwg\F4397-BASE.dwg, 8/24/2023 11:44:05 AM, [REC]

CONSTRUCTION ON THIS LAND IS SUBJECT TO ANY EASEMENTS, RIGHTS-OF-WAY, RESTRICTIONS, RESERVATIONS, OR OTHER LIMITATIONS WHICH MAY BE REVEALED BY AN EXAMINATION OF THE TITLE.