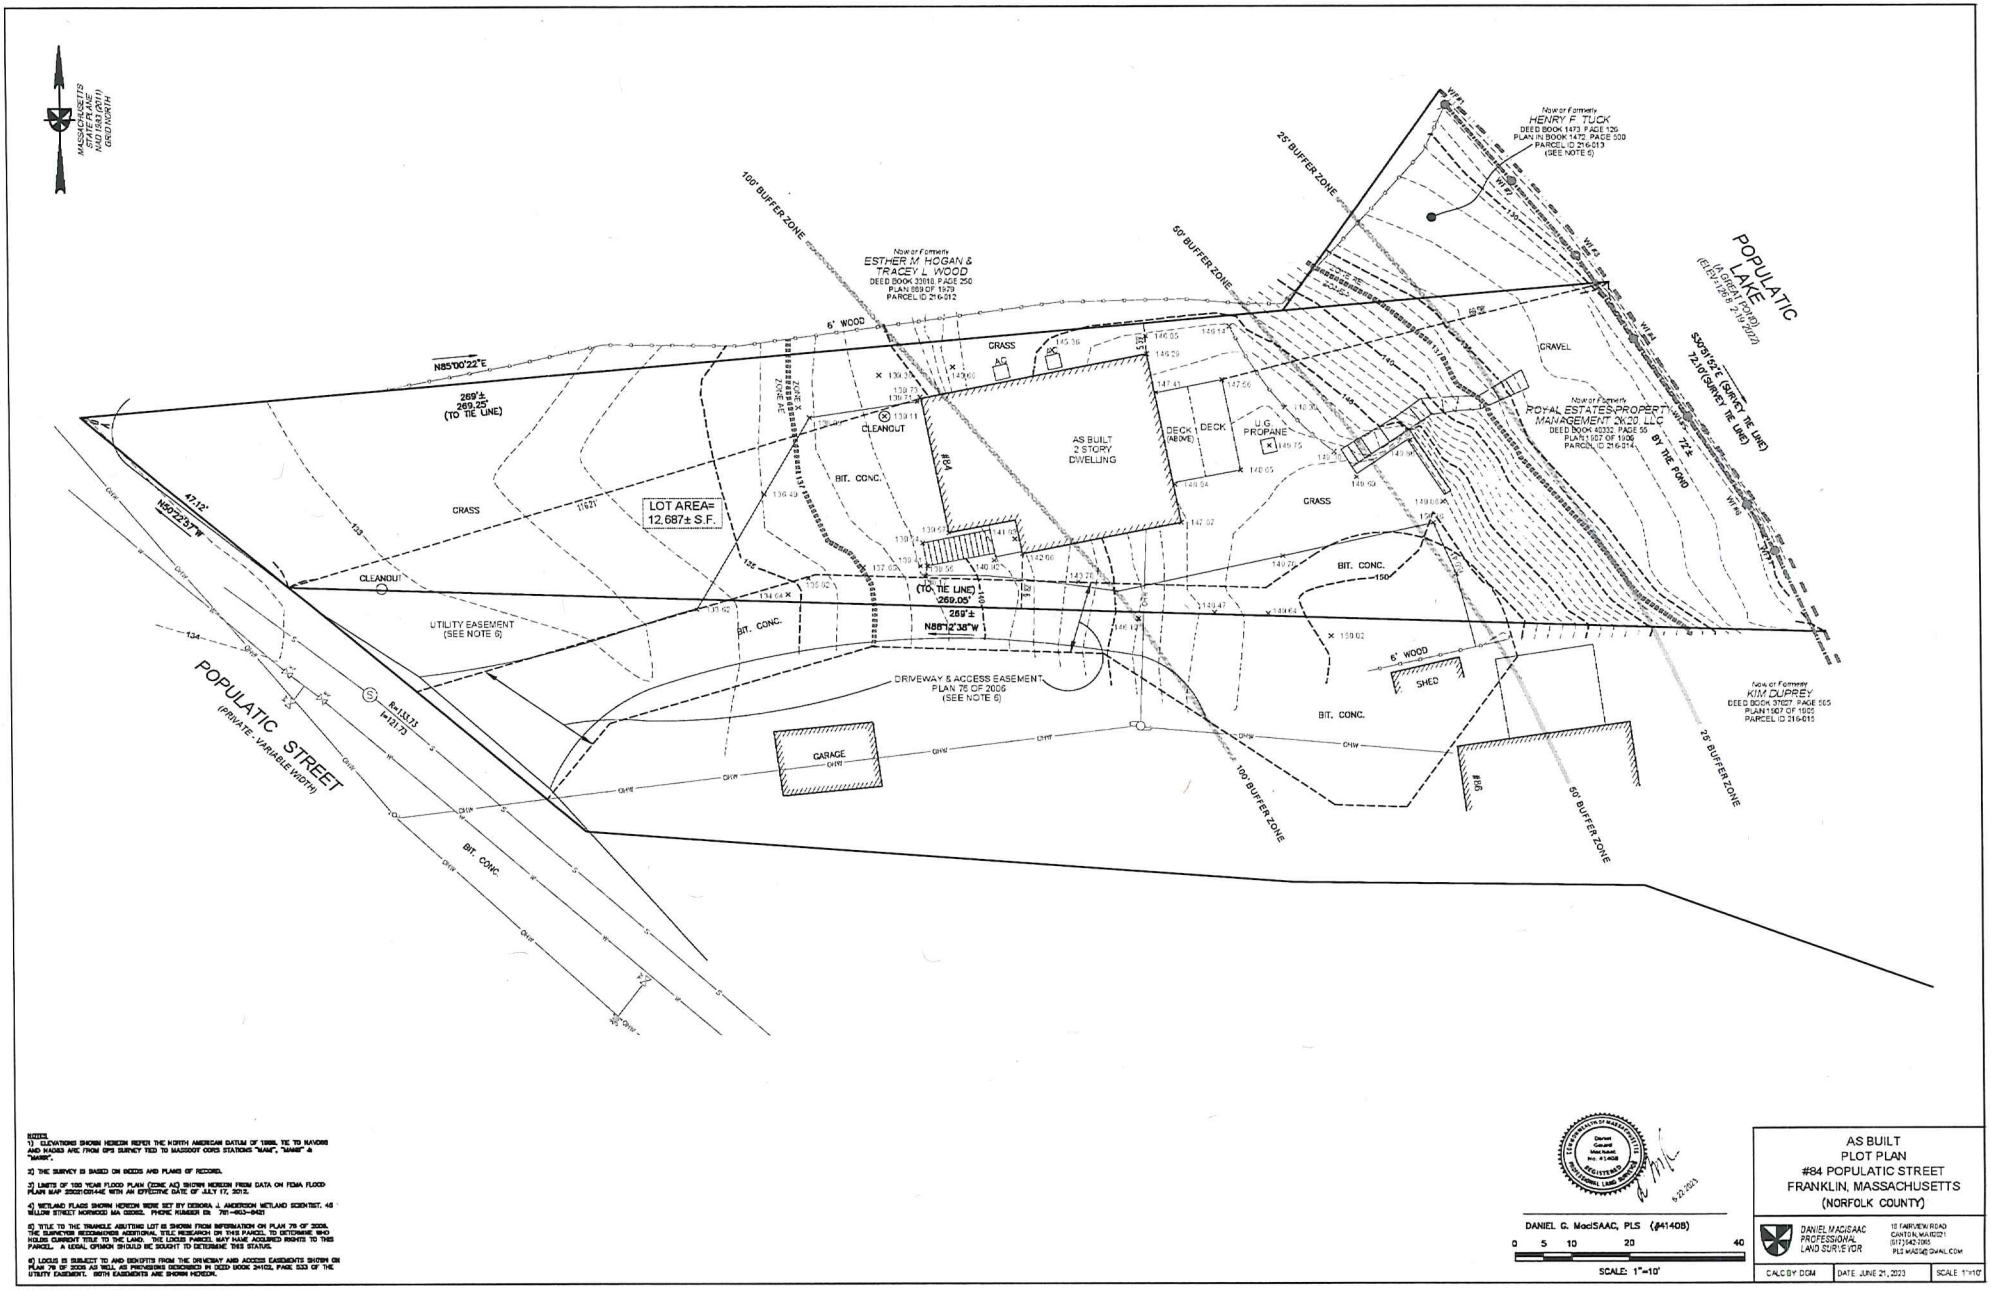
MASSACHUSETTS STATE PLANE NAD 1983 (2011) GRID NORTH
Now or Formerly
HENRY F. TUCK
DEED BOOK 1473 PAGE 120
PLAN IN BOOK 1472 PAGE 500
PARCEL ID 216-013
(SEE NOTE 6)
Now or Formerly
ESTHER M. HOGAN & TRACEY L. WOOD
DEED BOOK 33018 PAGE 256
PLAN 689 OF 1979
PARCEL ID 216-012
Now or Formerly
ROYAL ESTATES PROPERTY MANAGEMENT OK 20, LLC
DEED BOOK 40332 PAGE 55
PLAN 1507 OF 1905
PARCEL ID 216-014
Now or Formerly
KIM DUPREY
DEED BOOK 37027 PAGE 565
PLAN 1507 OF 1905
PARCEL ID 216-015
POPULATIC LAKE
(A GREAT POND)
POPULATIC STREET
(PRIVATE - VARIABLE WIDTH)
#84
#86
AS BUILT 2 STORY DWELLING
DECK 1 DECK (ABOVE)
U.G. PROPANE
GARAGE
SHED
CLEANOUT
LOT AREA= 12,687± S.F.
UTILITY EASEMENT (SEE NOTE 6)
DRIVEWAY & ACCESS EASEMENT PLAN 76 OF 2006 (SEE NOTE 6)
100' BUFFER ZONE
50' BUFFER ZONE
25' BUFFER ZONE
BIT. CONC.
GRASS
GRAVEL
6" WOOD
N85°00'22"E
269'± 269.25 (TO TIE LINE)
N86°12'38"W
269'± (TO TIE LINE) 269.05'
N50°22'57"W 47.12'
S30°12'57"E 72.10' (SURVEY TIE LINE)
72'± BY TIE FOND
R=133.33' L=121.73'
W1
W2
W3
W4
W5
W6
